

##ACTUALIZACION DE LAYOUT POR INDICACION DE AE (16-AGOSTO-2022)
EN PROBADORES: SE CAMBIA INSPIRATION WALL TIPO 'A' POR TIPO 'B'
EN AREA DE VENTA: SE AJUSTA CASHWRAP A 3 MODULOS
EN BODEGA: SE RETIRA MONTACARGAS Y SE REACOMODA MOBILIARIO Y RACKS
EN MEZZANINE: SE CANCELA AREA PARA BODEGA EN MEZZANINE

##ACTUALIZACION DE LAYOUT POR INDICACION DE AE (29-JULIO-2022)
EN PROBADORES: SE REUBICA PARTE DEL MOBILIARIO Y SE RECORRE EL ACCESO, DE MANERA QUE QUEDE EN LA PARTE TRASERA DE LA COLUMNA.
EN AREA DE VENTA: SE REUBICA ACCESO A PROBADORES Y MOBILIARIO.
EN BODEGA: SE RETIRA UNA SECCION DE RACKS PARA INTEGRAR MONTACARGAS EN PROYECTO.

##ACTUALIZACION DE ANAQUELES EN BODEGA Y GABINETE JOYERO, CONFORME INFORMACION RECIBIDA POR PROVEEDOR (07-OCT-2022)

####ACTUALIZACION LAYOUT POR INDICACION DE AE (12-OCTUBRE-2022)
EN BODEGA, SE QUITA EL GABINETE JOYERO, SE INDICA QUE SE ENCUENTRA DENTRO DE LOS RACKS REDHINTON, CONFORME A INFORMACION RECIBIDA POR PROVEEDOR.
SE CAMBIO EL ABATIMIENTO DE LA PUERTA DE ACCESO A BODEGA
SE CAMBIO EL AREA DE TABLEROS ELECTRICOS, DE PLANTA BAJA A MEZZANINE EXISTENTE


####ACTUALIZACION DE FACHADA POR INDICACION DE AE (14-OCTUBRE-2022)

####ACTUALIZACION DE CAJA DE LUZ EN AREA DE CAJA A 8'-0" (2438) X 6'-0" (1829) POR INDICACION DE AE (24-OCTUBRE-2022)


####ACTUALIZACION DE FACHADA POR INDICACION DE AE (27-OCTUBRE-2022)
ACTUALIZACION DE MUEBLE UPS EN BODEGA (28-OCTUBRE-2022)

ACTUALIZACION DE MUEBLE CAJA Y TRABAJA CON DIMENSIONES POR PROVEEDOR (16-NOVIEMBRE-2022)

##ACTUALIZACION DE ANAQUELES EN BODEGA Y GABINETE JOYERO, CONFORME INFORMACION RECIBIDA POR PROVEEDOR (12-DICIEMBRE-2022). VERIFICAR POSICION FINAL DE RACKS EN SITIO POR EXISTENCIA DE PLACA BASE EN COLUMNAS DE TAPANGO

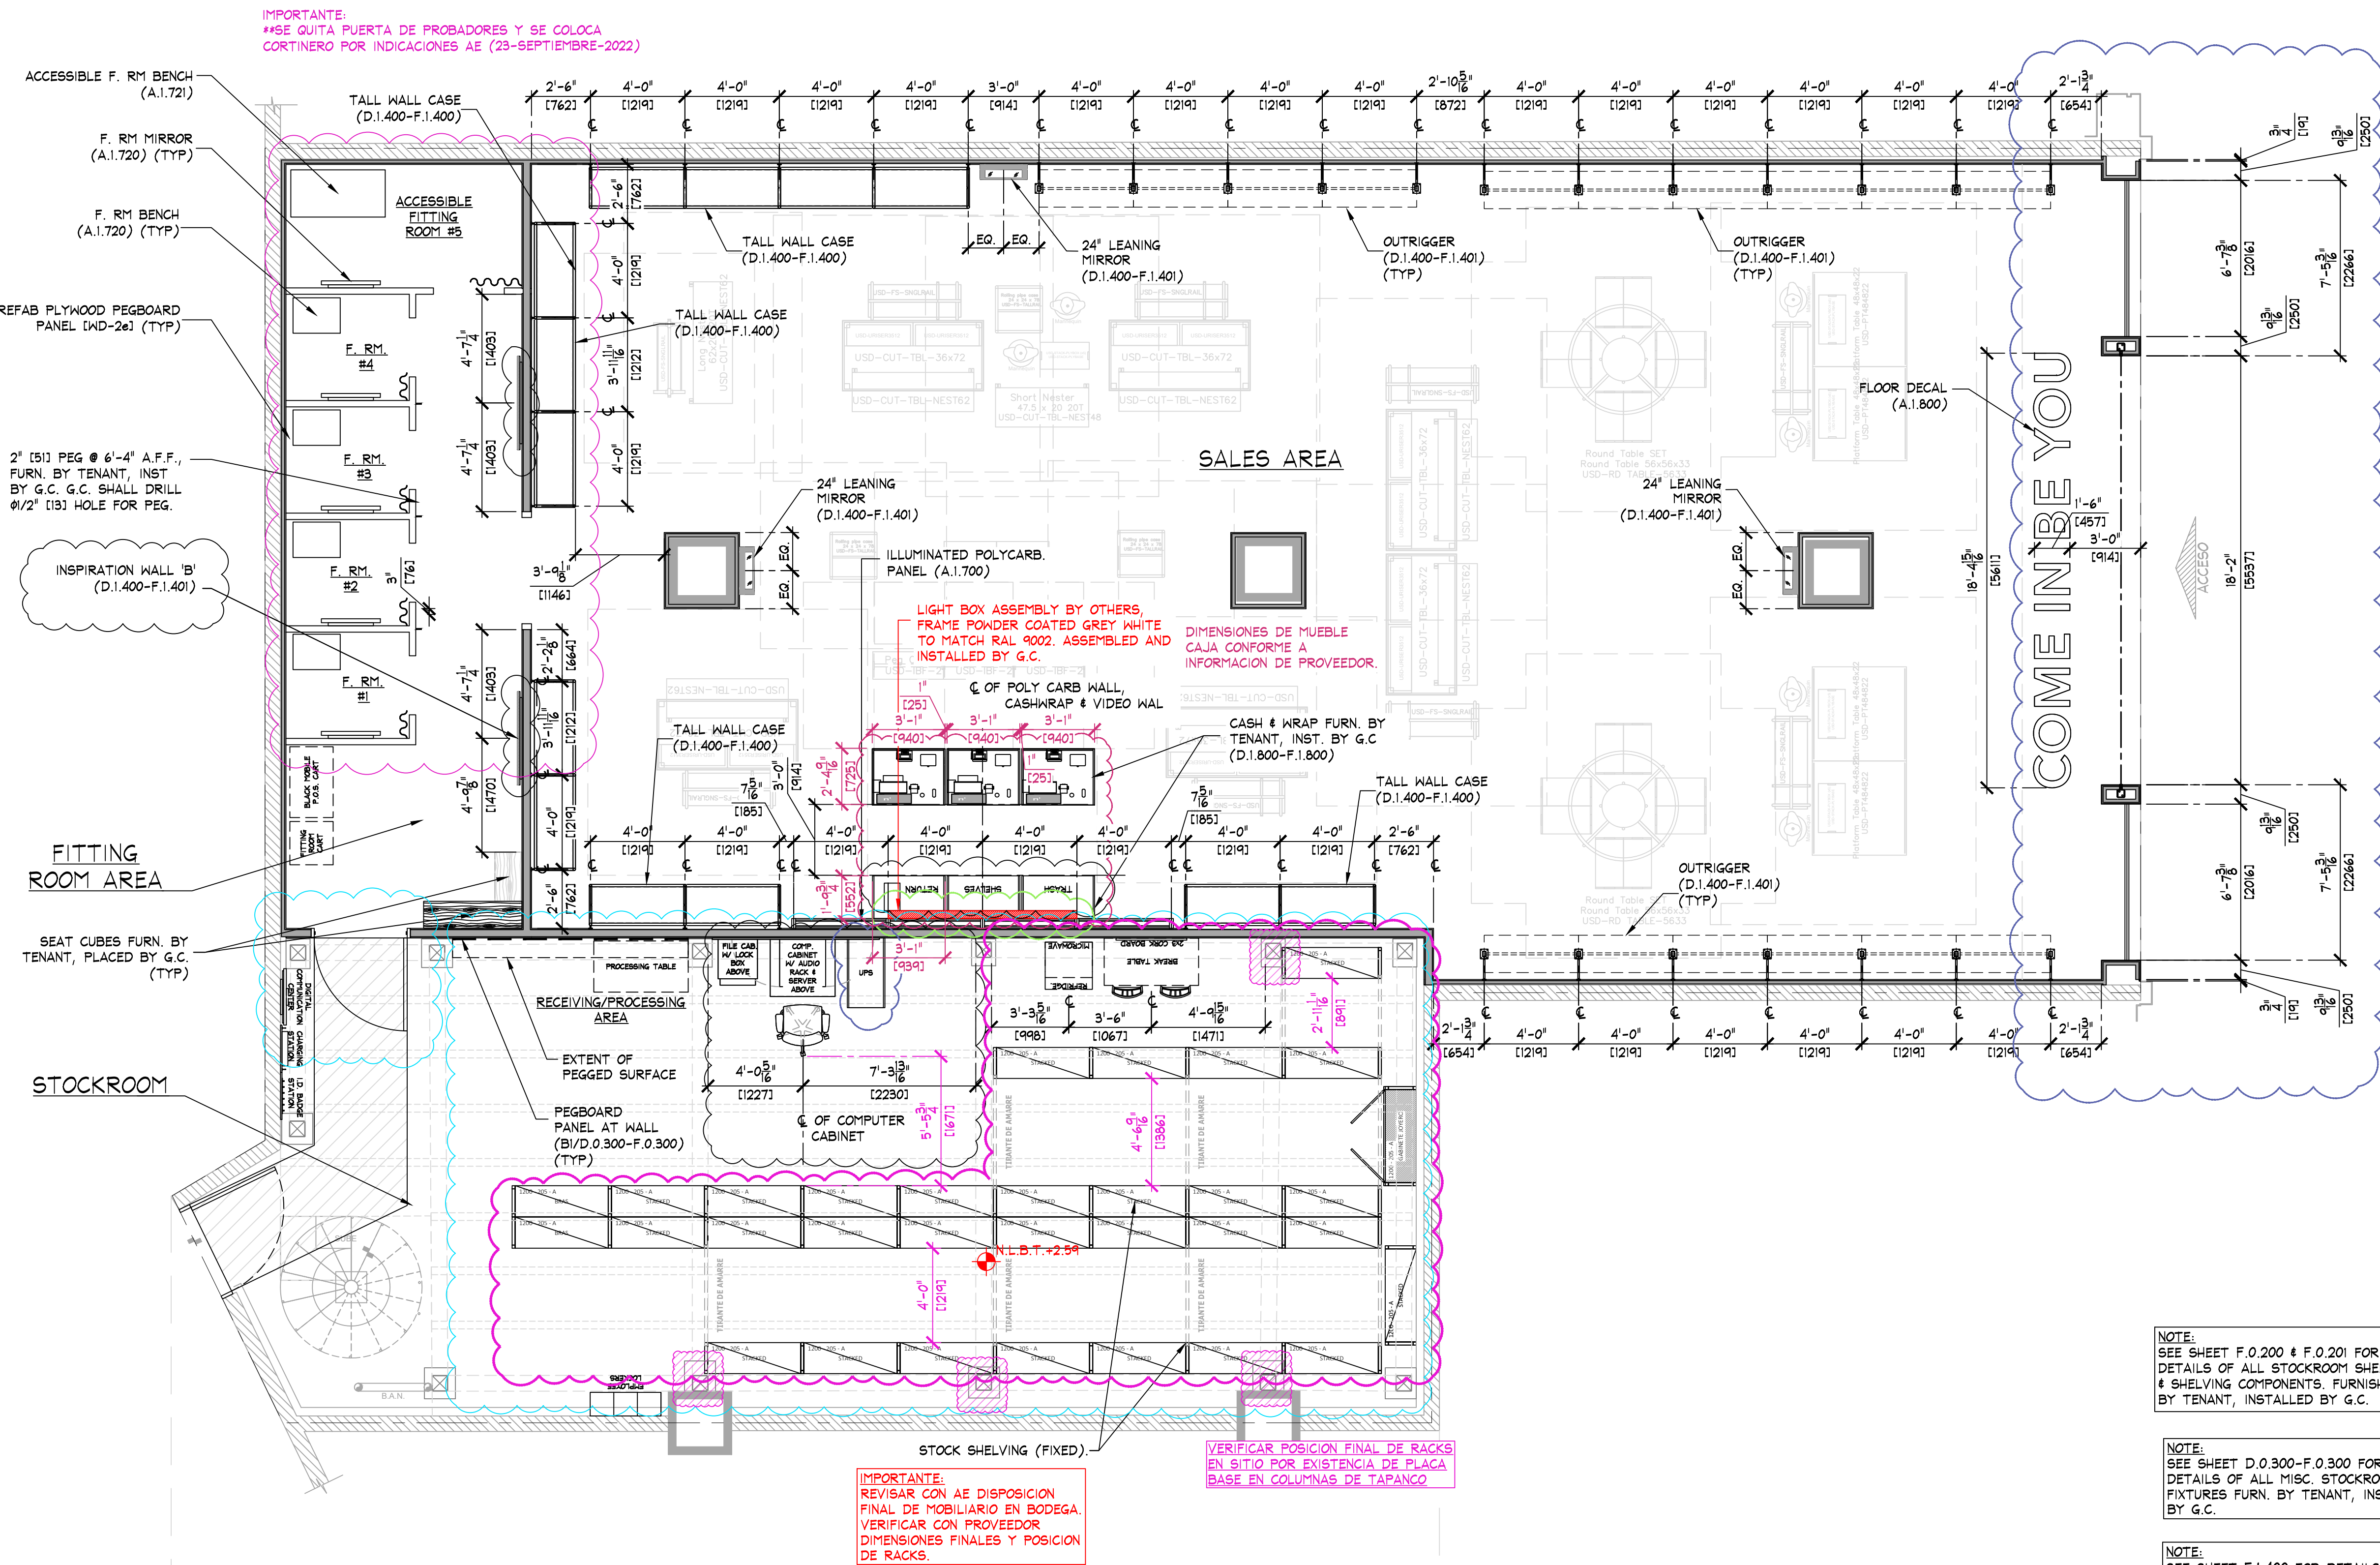

FIXTURE PLAN
SCALE: 1/4" = 1'-0"

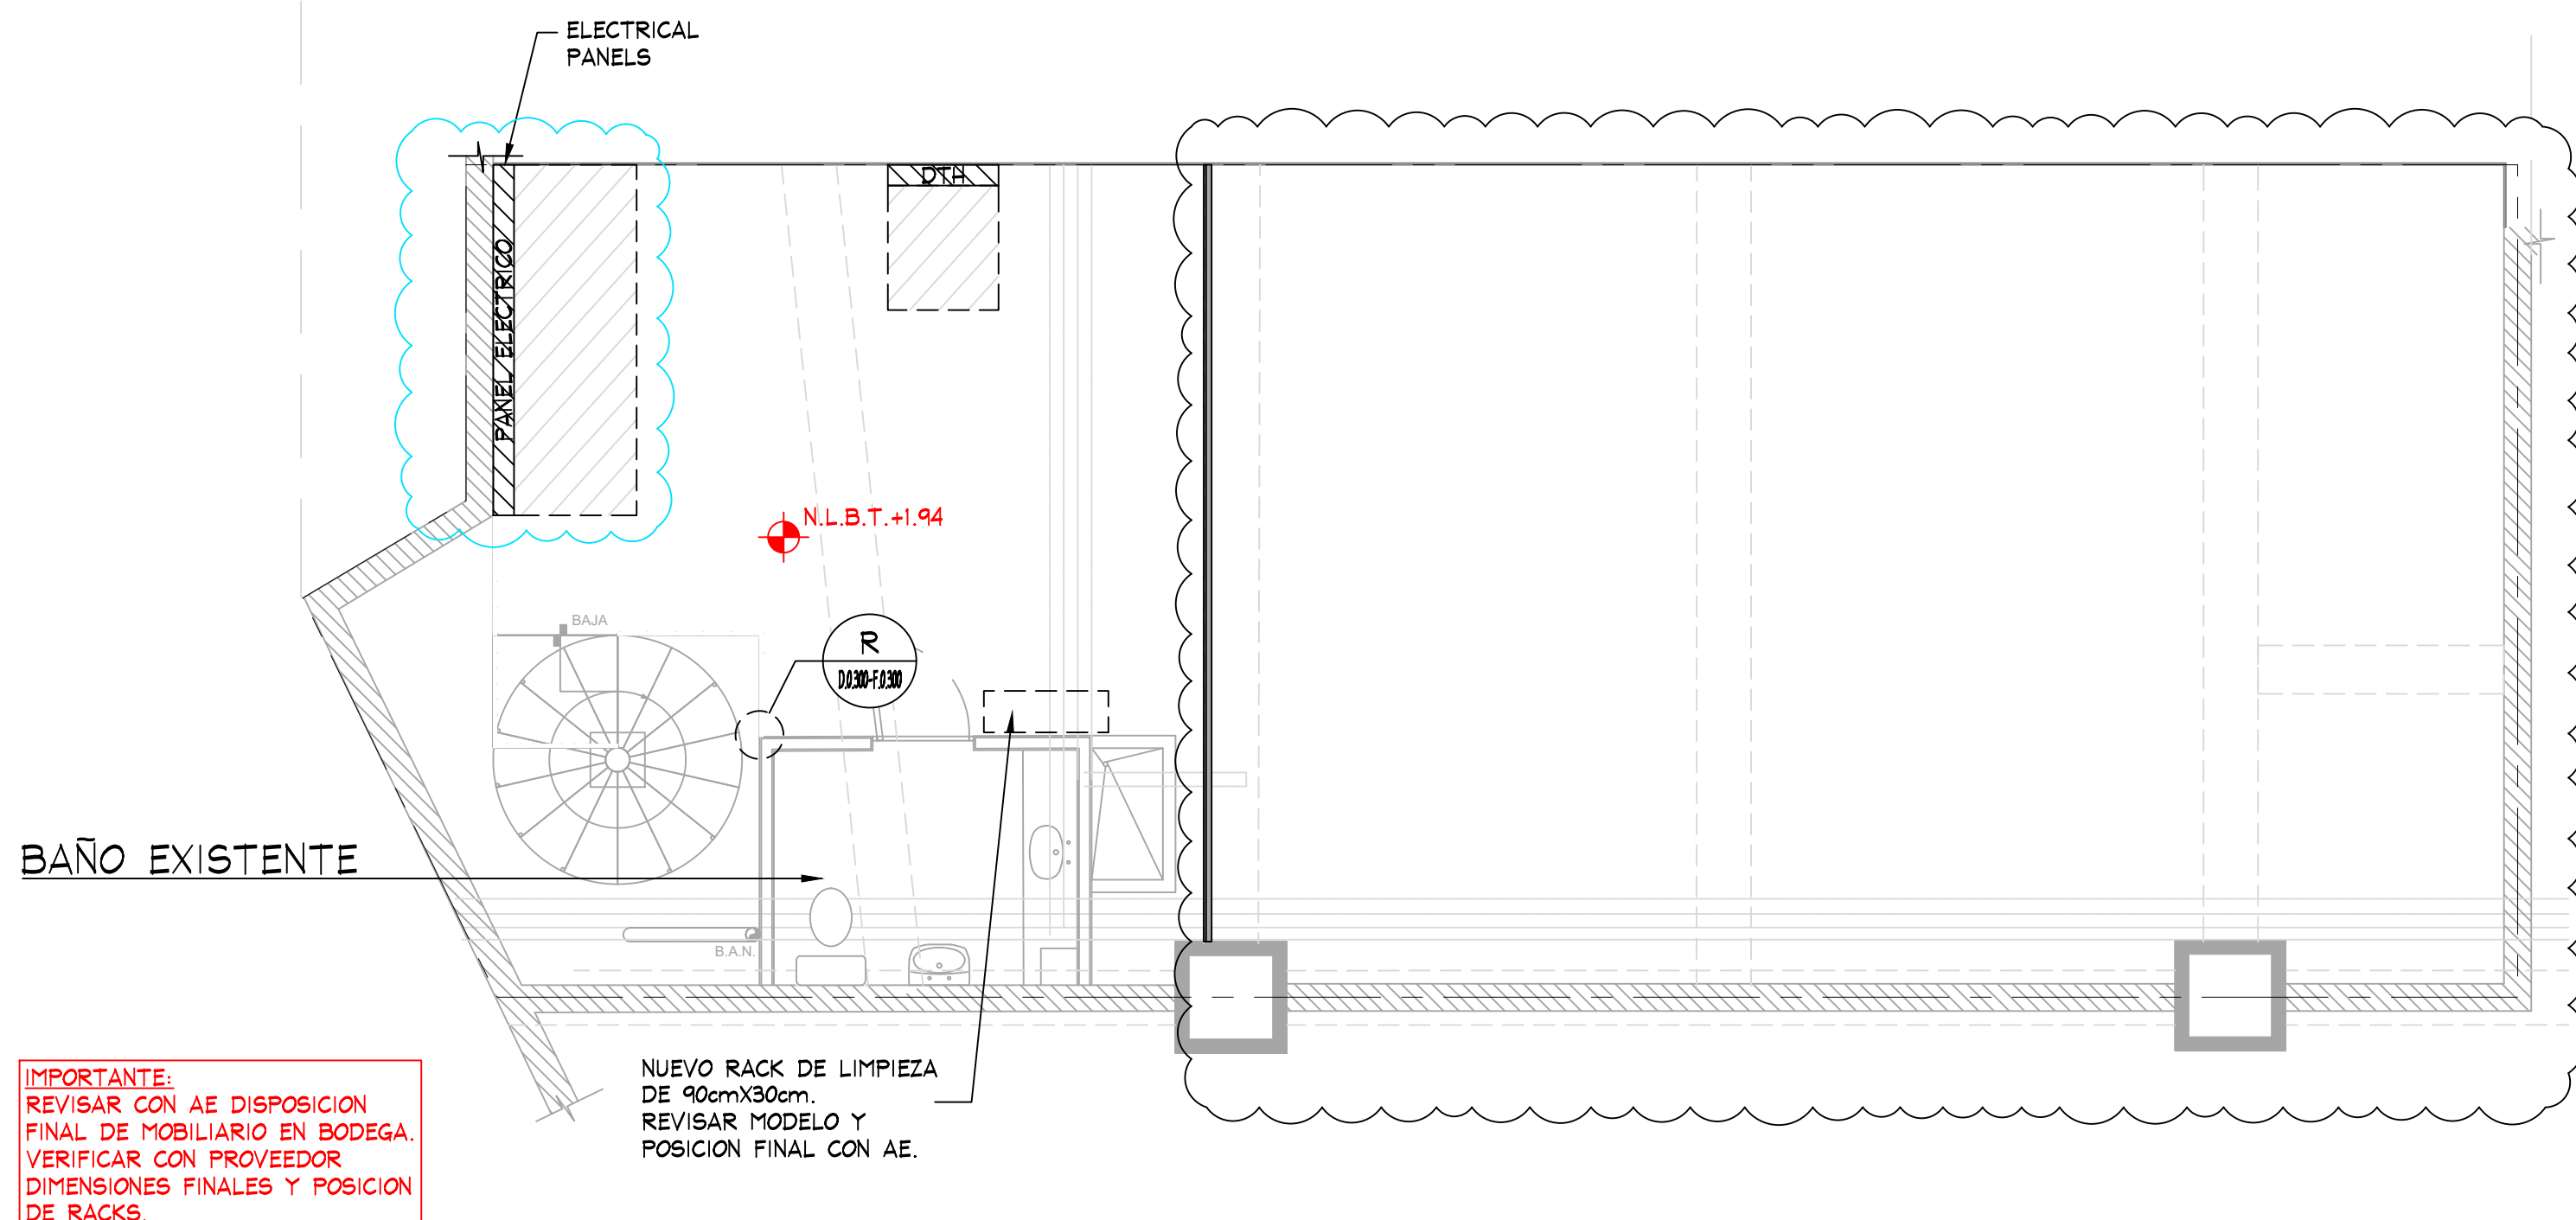

EXS MEZZANINE
SCALE: 1/4" = 1'-0"


AREA ANALYSIS			
AREA	M ²	FT ²	%
AE SALES AREA	207.4	2,233	48%
AE FITTING ROOMS	30.1	324	7%
AERIE SALES AREA	0	0	0%
AERIE FITTING ROOMS	0	0	0%
STOCK ROOM	111.9	1,205	26%
EXS. TOILET ROOMS	3.9	42	1%
EGRESS CORRIDOR	0	0	0%
AE DISPLAY	0	0	0%
AERIE DISPLAY	0	0	0%
OTHER	0	0	0%
UNUSED	81.9	882	19%
TOTAL	435.3	4686	100%

##ACTUALIZACION DE LAYOUT POR INDICACION DE AE (16-AGOSTO-2022)
ACTUALIZACION DE TABLA POR AJUSTE DE LAYOUT

NOTE:
SEE SHEET F.0.200 & F.0.201 FOR DETAILS OF ALL STOCKROOM SHELVING & SHELVING COMPONENTS FURNISHED BY TENANT, INSTALLED BY G.C.

NOTE:
SEE SHEET D.0.300-F.0.300 FOR DETAILS OF ALL MISC. STOCKROOM FIXTURES FURN. BY TENANT, INST. BY G.C.


NOTE:
SEE SHEET F.1.400 FOR DETAILS OF ALL MISC. SALES/FITTING ROOM FIXTURES FURN. BY TENANT, INST. BY G.C.

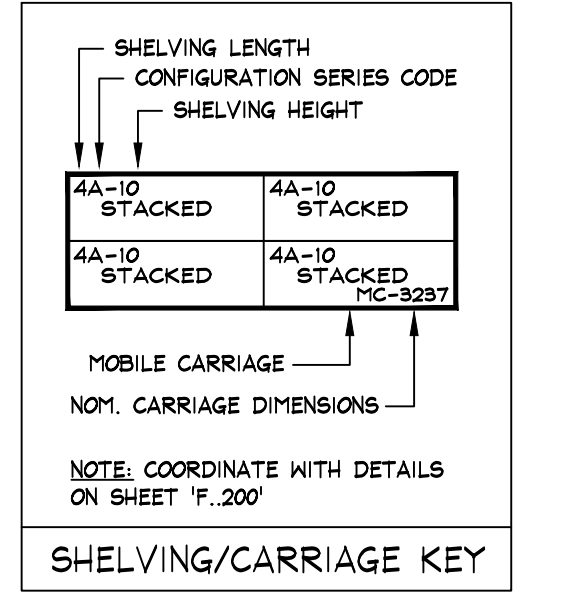

NOTE:
PRIOR TO INSTALLATION OF STOCKROOM SHELVING & STOCKROOM ACCESSORY ITEMS, G.C. SHALL VERIFY THAT ALL STOCKROOM COMPONENTS CAN BE INSTALLED AS SHOWN ON THIS DRAWING. IF FIELD CONDITIONS PROHIBIT INSTALLATION AS SHOWN, OR PRESENT OPPORTUNITIES FOR EXPANSION, G.C. SHALL NOT CONTINUE WITH ANY INSTALLATION AND NOTIFY TENANT FIELD REP IMMEDIATELY.

NOTE:
SALES AREA SHELVING SHOWN FOR SCHEMATIC PURPOSES ONLY. ACTUAL CONFIGURATION MAY VARY.


NOTE:
PARTNER TO CONFIRM STOCK AREA COMPONENTS DESIRED/REQUIRED. COORDINATE WITH AMERICAN EAGLE REPRESENTATIVE.

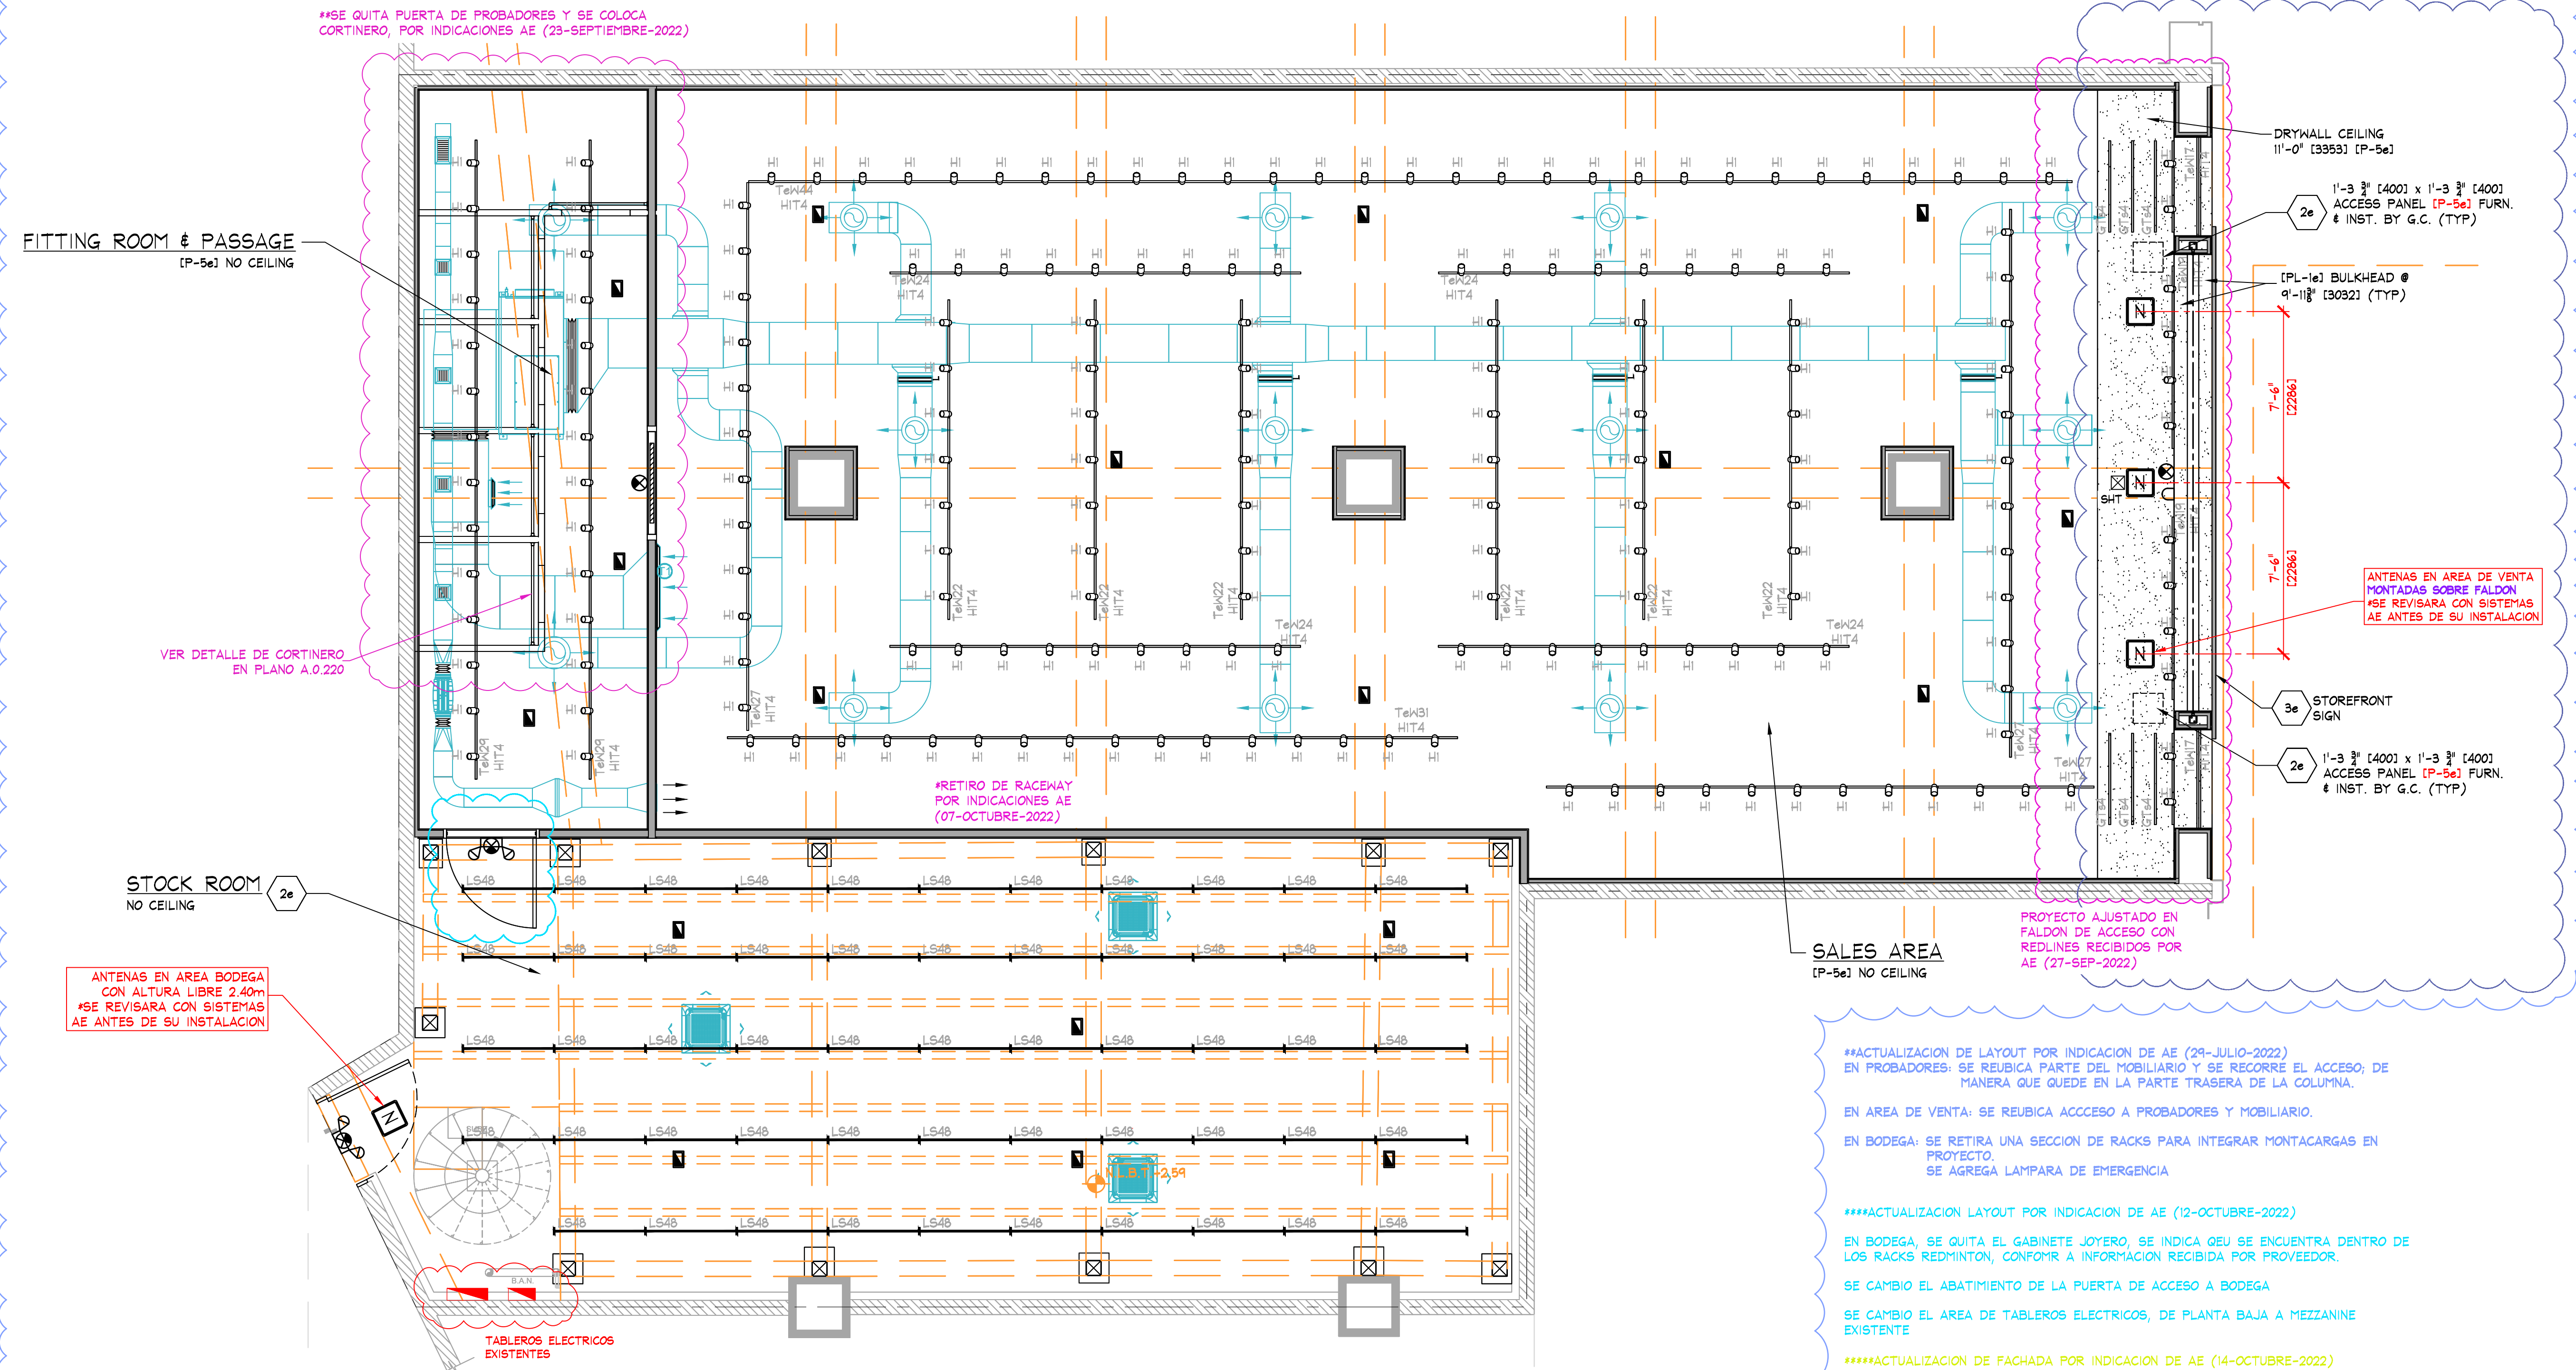

DEVICE COORDINATION REFLECTED CEILING PLAN

SCALE: 1/4" = 1'-0"

INDICA AJUSTES EN PLANO POR DUCTERIA/EQUIPO DE A.A.

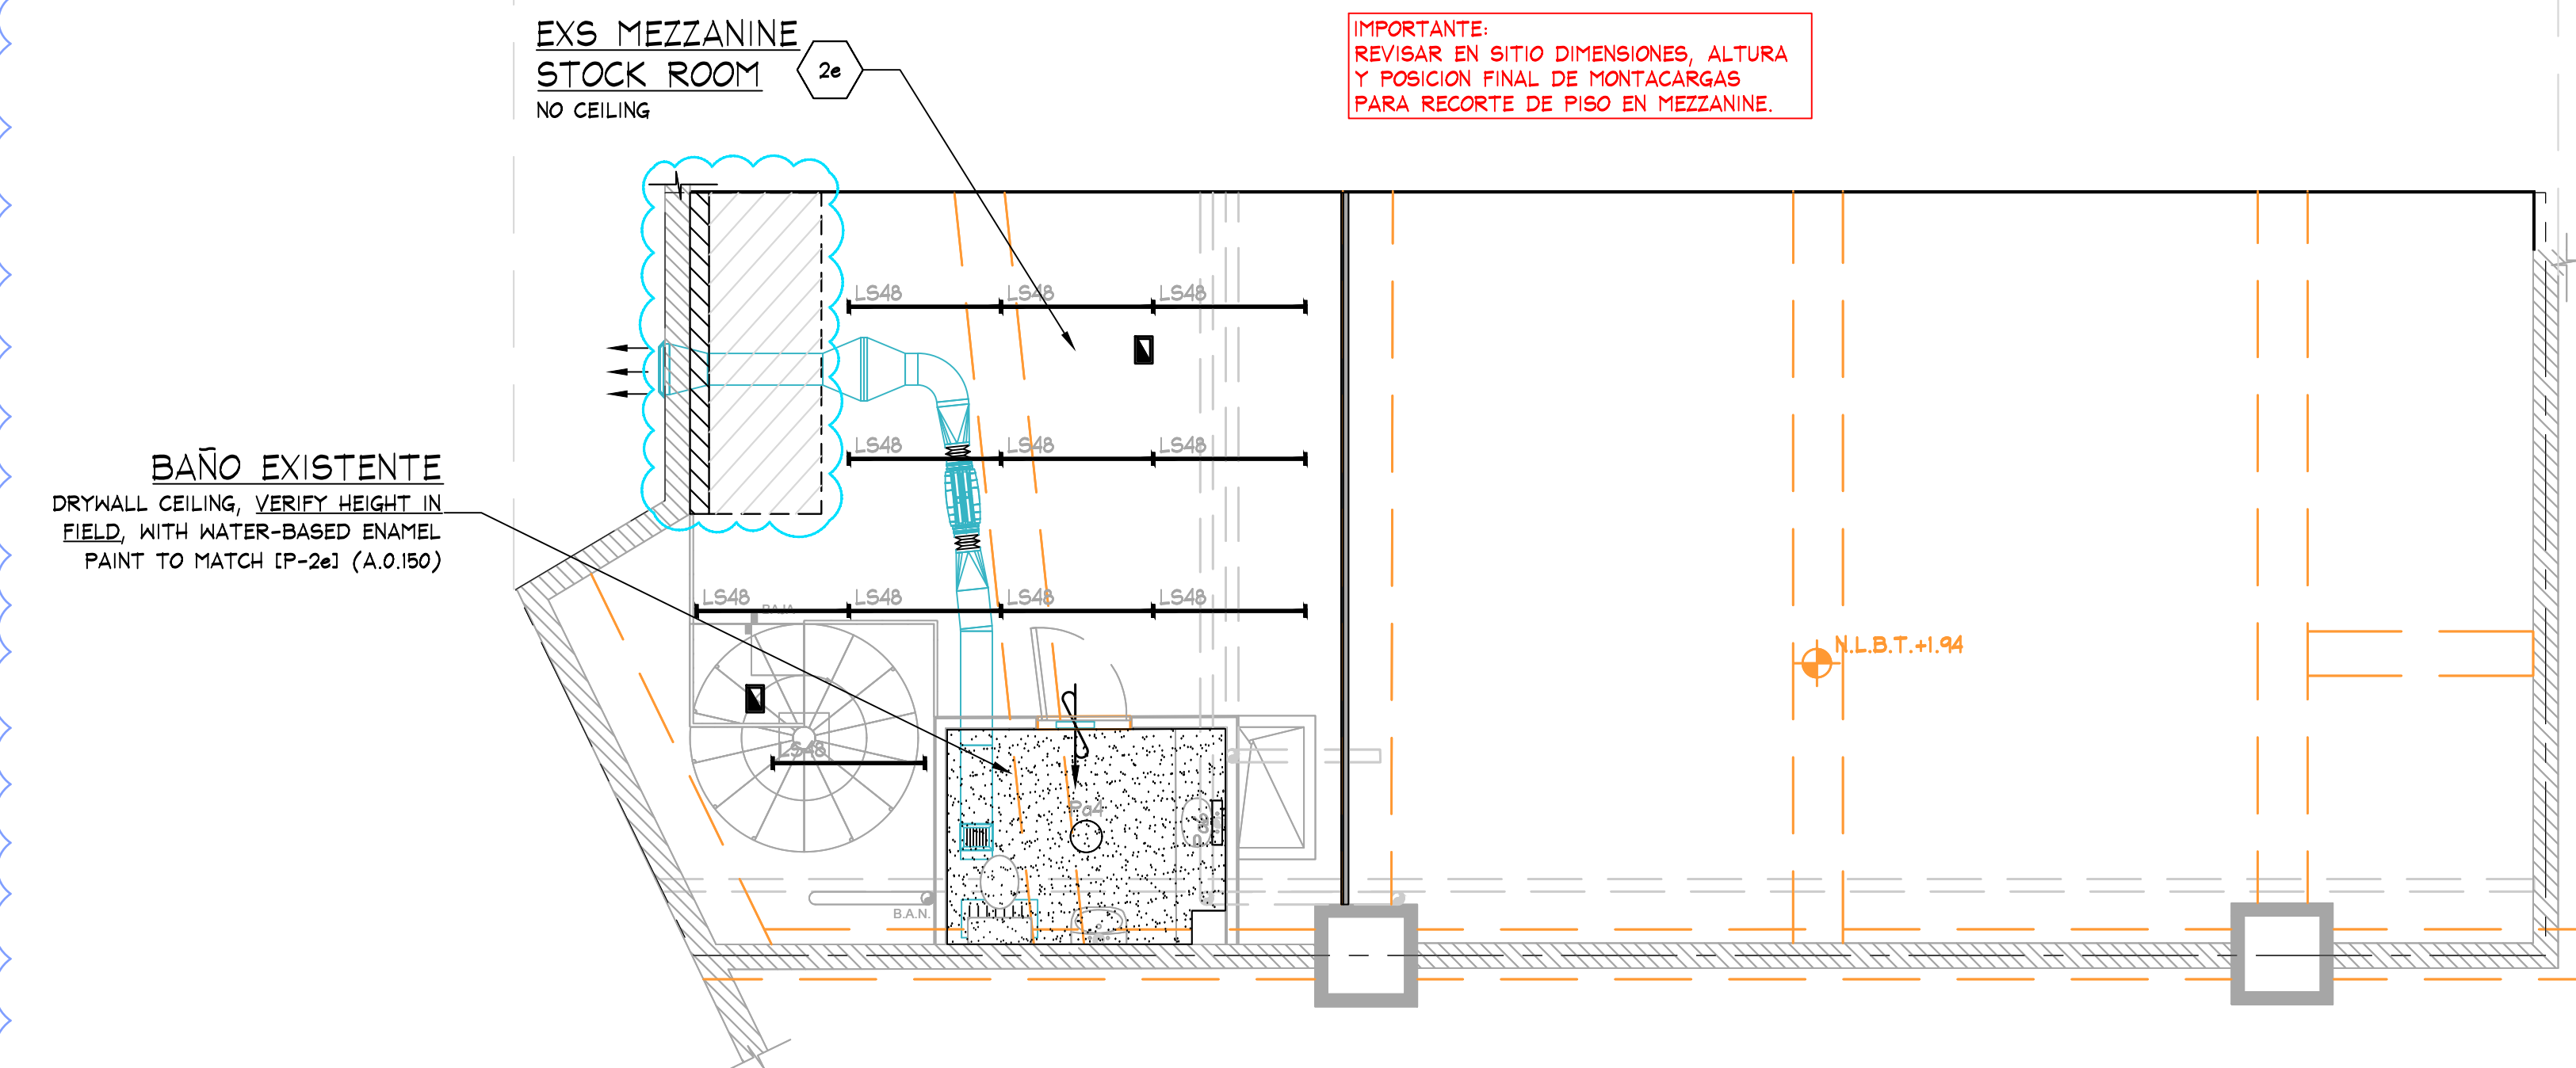

EXS MEZZANINE

SCALE: 1/4" = 1'-0"

SYMBOL LEGEND	
	SUPPLY AIR DIFFUSER, WHITE COLOR, DIFUSOR CIRCULAR PARA ZONAS SIN PLAFON.
	SUPPLY AIR DIFFUSER, WHITE COLOR, DIFUSOR CUADRADO PARA ZONAS CON PLAFON.
	SUPPLY AIR DIFFUSER (LINEAR), WHITE COLOR, DIFUSOR LINEAL PARA ZONAS CON PLAFON.
	RETURN / EXHAUST REGISTER (OR GRILLE), WHITE COLOR.
	PENDANT MTD. EMERGENCY LIGHT
	SURFACE EMERGENCY LIGHT
	EXIT SIGN COLOCAR SOBRE MOLDURA/FALDON (VER PLANO A.1.300/A.2.300)
	ESTROBO COLOCAR SOBRE MOLDURA/FALDON (VER PLANO A.1.300/A.2.300)
	SHOPPER TRACK ALTURA LIBRE ACORDE A PROYECTO (VER PLANO A.1.300/A.2.300)
	SECURITY BY OTHERS ANTENA, ALTURA LIBRE ACORDE A PROYECTO EN AREA DE VENTA. (VER PLANO A.1.300/A.2.300) ANTENA, ALTURA LIBRE EN BODEGA 2.40m

NOTE:
ALL EMERGENCY LIGHTING SHALL BE WIRED "HOT" UN-SWITCHED.

NOTE:
SEE SHEET 'A.0.200' FOR FIXTURE LOCATING DIMENSIONS.

NOTE:
SECURE ALL LIGHTING TRACK TO CEILING WITH TOGGLE BOLTS WHERE OCCURS

NOTE:
SEE SHEET A.0.200 FOR ALL CEILING HEIGHTS.

NOTE:
SEE SHEET E.0.400 AND/OR E.0.401 FOR ELECTRICAL INSTALLATION DETAILS.

NOTE:
ALL HVAC INSTALLATION SHALL BE GRAY COLOR TO MATCH (P-5e); ALL DIFFUSERS SHALL BE WHITE COLOR

NOTE:
G.C. TO PAINT EVERYTHING ABOVE 11'-0" (P-5e) DO NOT PAINT EQUIPMENT INFORMATION TAGS!

NOTE:
REFER TO SHEET E.0.500 FOR ALL CEILING MOUNTED LOW VOLTAGE DEVICES. REFER TO SHEET E.0.501 FOR INSTALLATION OF LOW VOLTAGE DEVICES.

NOTE:
SEE SHEET E.0.101 FOR LIGHTING FIXTURE AND TRACK SCHEDULES

NOTE:
PRIOR TO START ANY INSTALLATION WORK, G.C. SHALL VERIFY FINAL LOCATION SYSTEM PLANS AS REQUIRED FOR THIS PROJECT (CCTV, SENSORMATIC, ETC.)

NOTE:
SE DEBERA REVISAR LA ALTURA TOTAL EXISTENTE EN LOCAL

NOTE:
NO WIRING SHALL EXTEND FROM SUPPORT TRACK TO ANY OTHER SUPPORT TRACK, WALL, OR PERIMETER CONSTRUCTION. ALL WIRING RUNS SHALL BE STRAIGHT HORIZONTAL OR VERTICAL STRAP AND SECURE AS REQUIRED TO MAINTAIN ORGANIZED LOOK.
ALL WIRING AT PERIMETER WALLS SHALL BE STRAPPED NEATLY HORIZONTAL OR VERTICAL AS REQUIRED.
ALL VALANCE OR PERIMETER WIRING SHALL BE STRAPPED TIGHTLY TO THE TOP OF VALANCE CASE TO ELIMINATE VIEW FROM SALES FLOOR.
ALL ELECTRICAL BOXES SHOULD BE HELD TIGHT TO WALLS.


NOTE:
ALL COMPONENTS REQUIRED TO SUPPORT AND INSTALL THE SUSPENDED CEILING SYSTEM (WHETHER DRYWALL AND/OR ACOUSTIC TILE), ARE TO BE FURNISHED AND INSTALLED BY G.C. - G.C. SHALL CONSULT WITH MALL/BUILDING DEPARTMENT TO DETERMINE REQUIRED METHODS FOR SUPPORTING CEILING FROM MALL STRUCTURE, PRIOR TO SUBMITTING BID.

KEY NOTES:
2e STOCKROOM CEILING - NO CEILING, UNLESS REQUIRED BY LANDLORD OR LOCAL BUILDING CODES - (CT-2e). SUSPENSION SYSTEM SHALL BE AS MANUFACTURED BY USG INTERIORS, INC. DOWN CEILING SUSPENSION DXL SERIES, WHITE EXPOSED 2'x4' GRID SYSTEM.
3e SIGN - FURNISHED BY SIGN CONSULTANT, INSTALLED BY G.C. SEE SHEET A.1.800 FOR MORE INFORMATION.


IMPORTANT:
ORANGE COLOR INDICATES STRUCTURAL ELEMENTS.

NOTE:
ALL SUPPORT TRACK AND RELATED COMPONENTS, REQUIRED TO SUPPORT TRACK LIGHTING FIXTURES ONLY, ARE TO BE FURNISHED BY TENANT & INSTALLED BY G.C. - G.C. SHALL ENSURE THAT ALL SUPPORT TRACK IS INSTALLED WITH FIRST CLASS WORKMANSHIP. LEVEL, STRAIGHT, & ALIGNED.
ALL OTHER EQUIPMENT/COMPONENT SUPPORTS (UNISTRUT, CLAMPS, NUTS, BOLTS, WASHERS, ETC.) FURN. & INST. BY G.C.

***ACTUALIZACION DE LAYOUT POR INDICACION DE AE (29-JULIO-2022)
EN PROBADORES: SE REUBICA PARTE DEL MOBILIARIO Y SE RECORRE EL ACCESO; DE MANERA QUE QUEDA EN LA PARTE TRASERA DE LA COLUMNA.
EN AREA DE VENTA: SE REUBICA ACCESO A PROBADORES Y MOBILIARIO.
EN BODEGA: SE RETIRA UNA SECCION DE RACKS PARA INTEGRAR MONTACARGAS EN PROYECTO.
SE AGREGA LAMPARA DE EMERGENCIA
***ACTUALIZACION LAYOUT POR INDICACION DE AE (12-OCTUBRE-2022)
EN BODEGA, SE QUITA EL GABINETE JOYERO, SE INDICA QUE SE ENCUENTRA DENTRO DE LOS RACKS REDMINTON, CONFORME A INFORMACION RECIBIDA POR PROVEEDOR.
SE CAMBIO EL ABATIMIENTO DE LA PUERTA DE ACCESO A BODEGA
SE CAMBIO EL AREA DE TABLEROS ELECTRICOS, DE PLANTA BAJA A MEZZANINE EXISTENTE
*****ACTUALIZACION DE FACHADA POR INDICACION DE AE (14-OCTUBRE-2022)
*****ACTUALIZACION DE FACHADA POR INDICACION DE AE (27-OCTUBRE-2022)

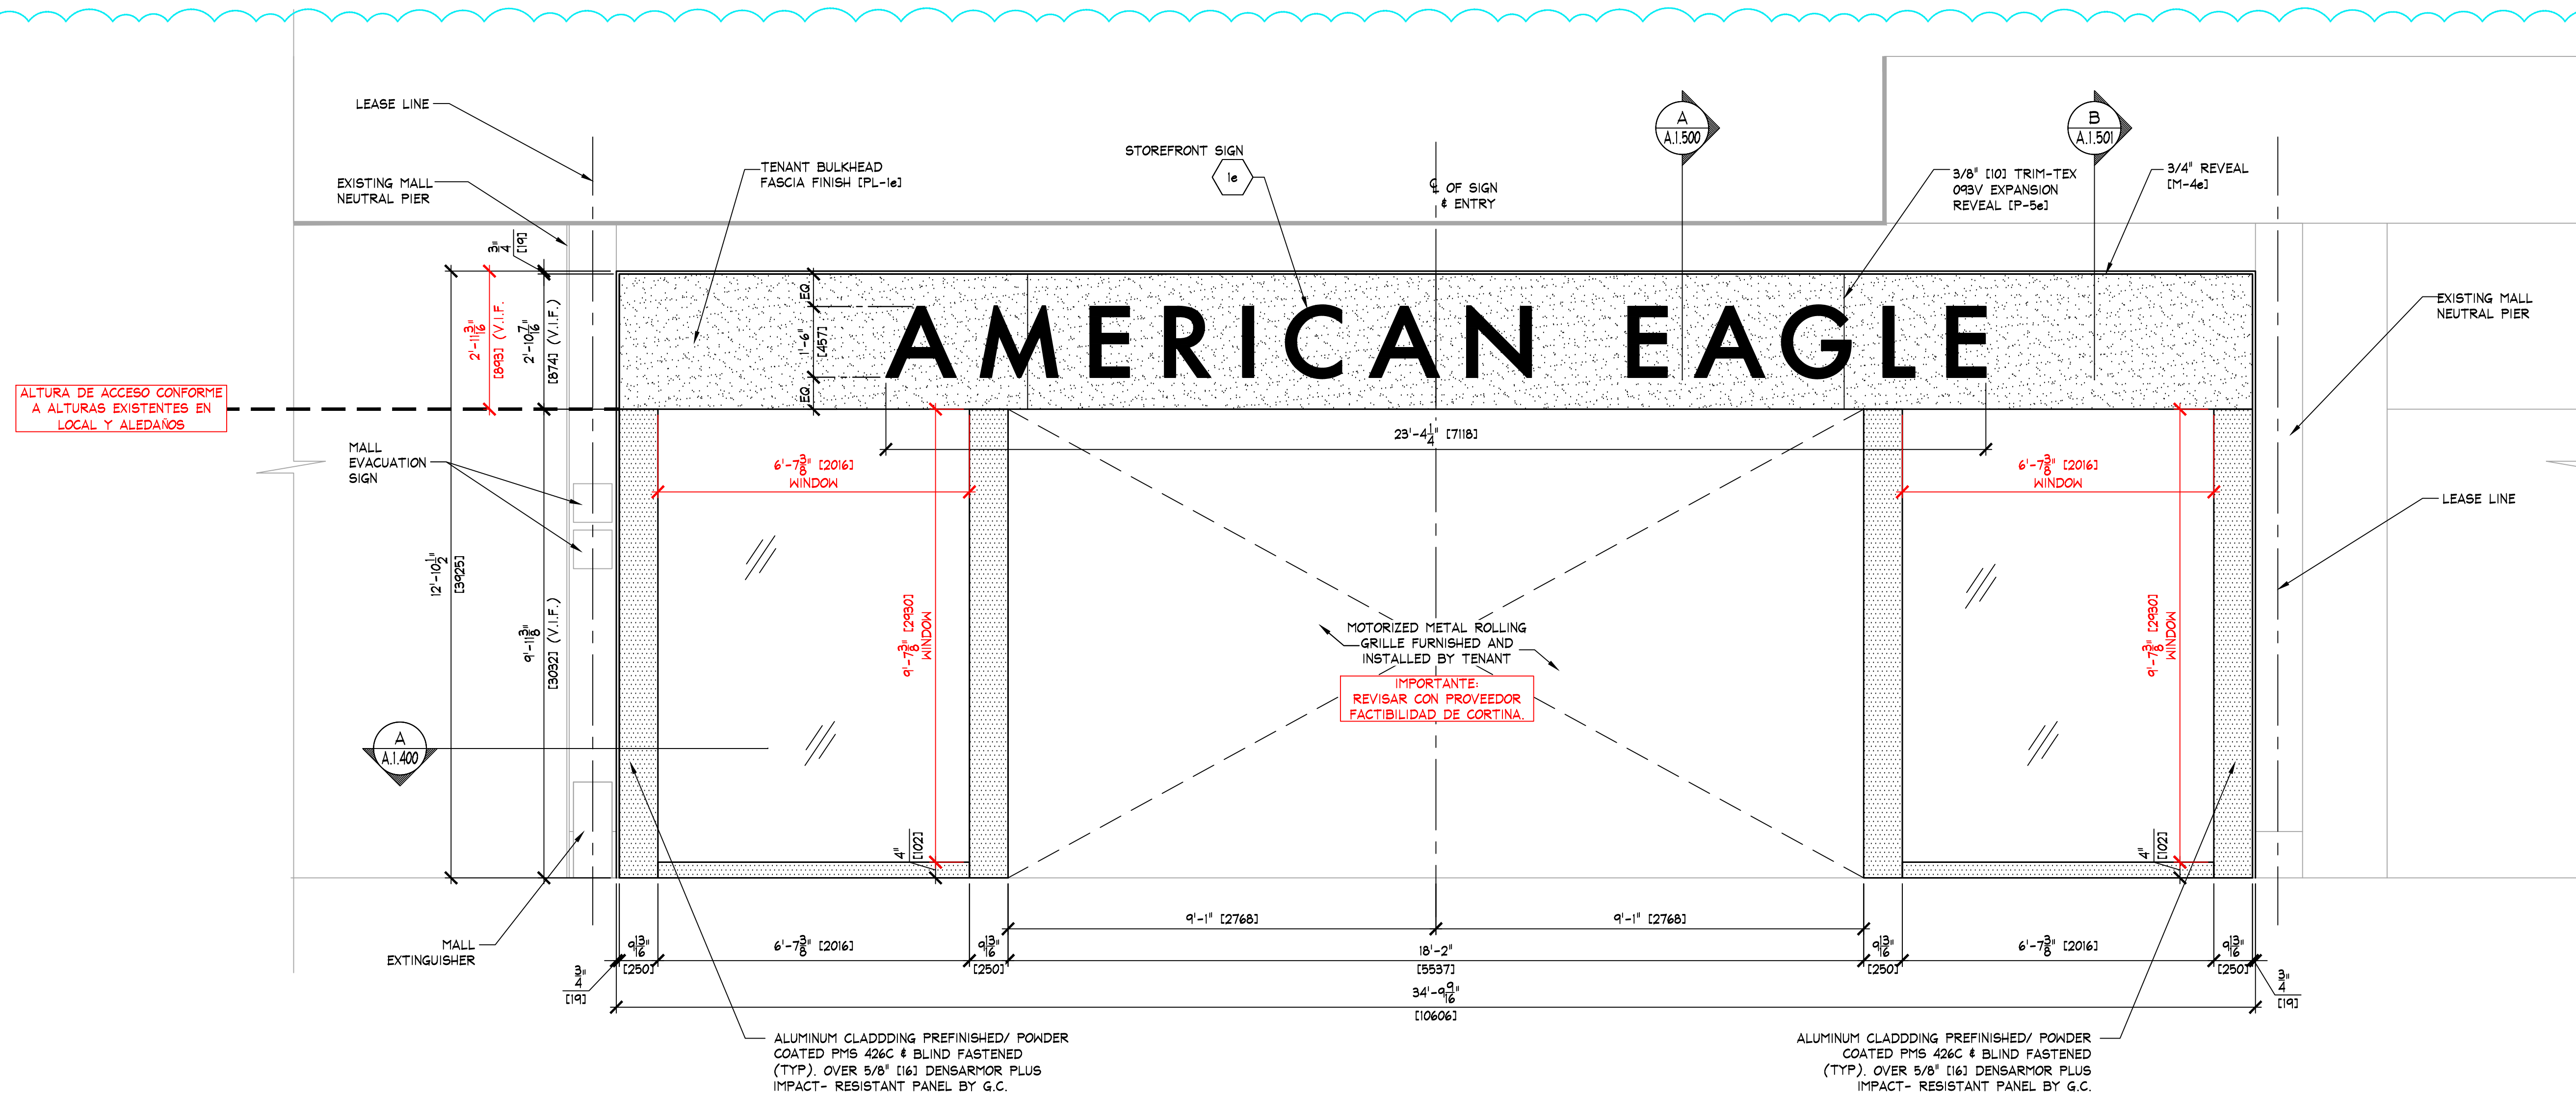

A STOREFRONT EXTERIOR ELEVATION
SCALE: 1/2" = 1'-0" (1/25)

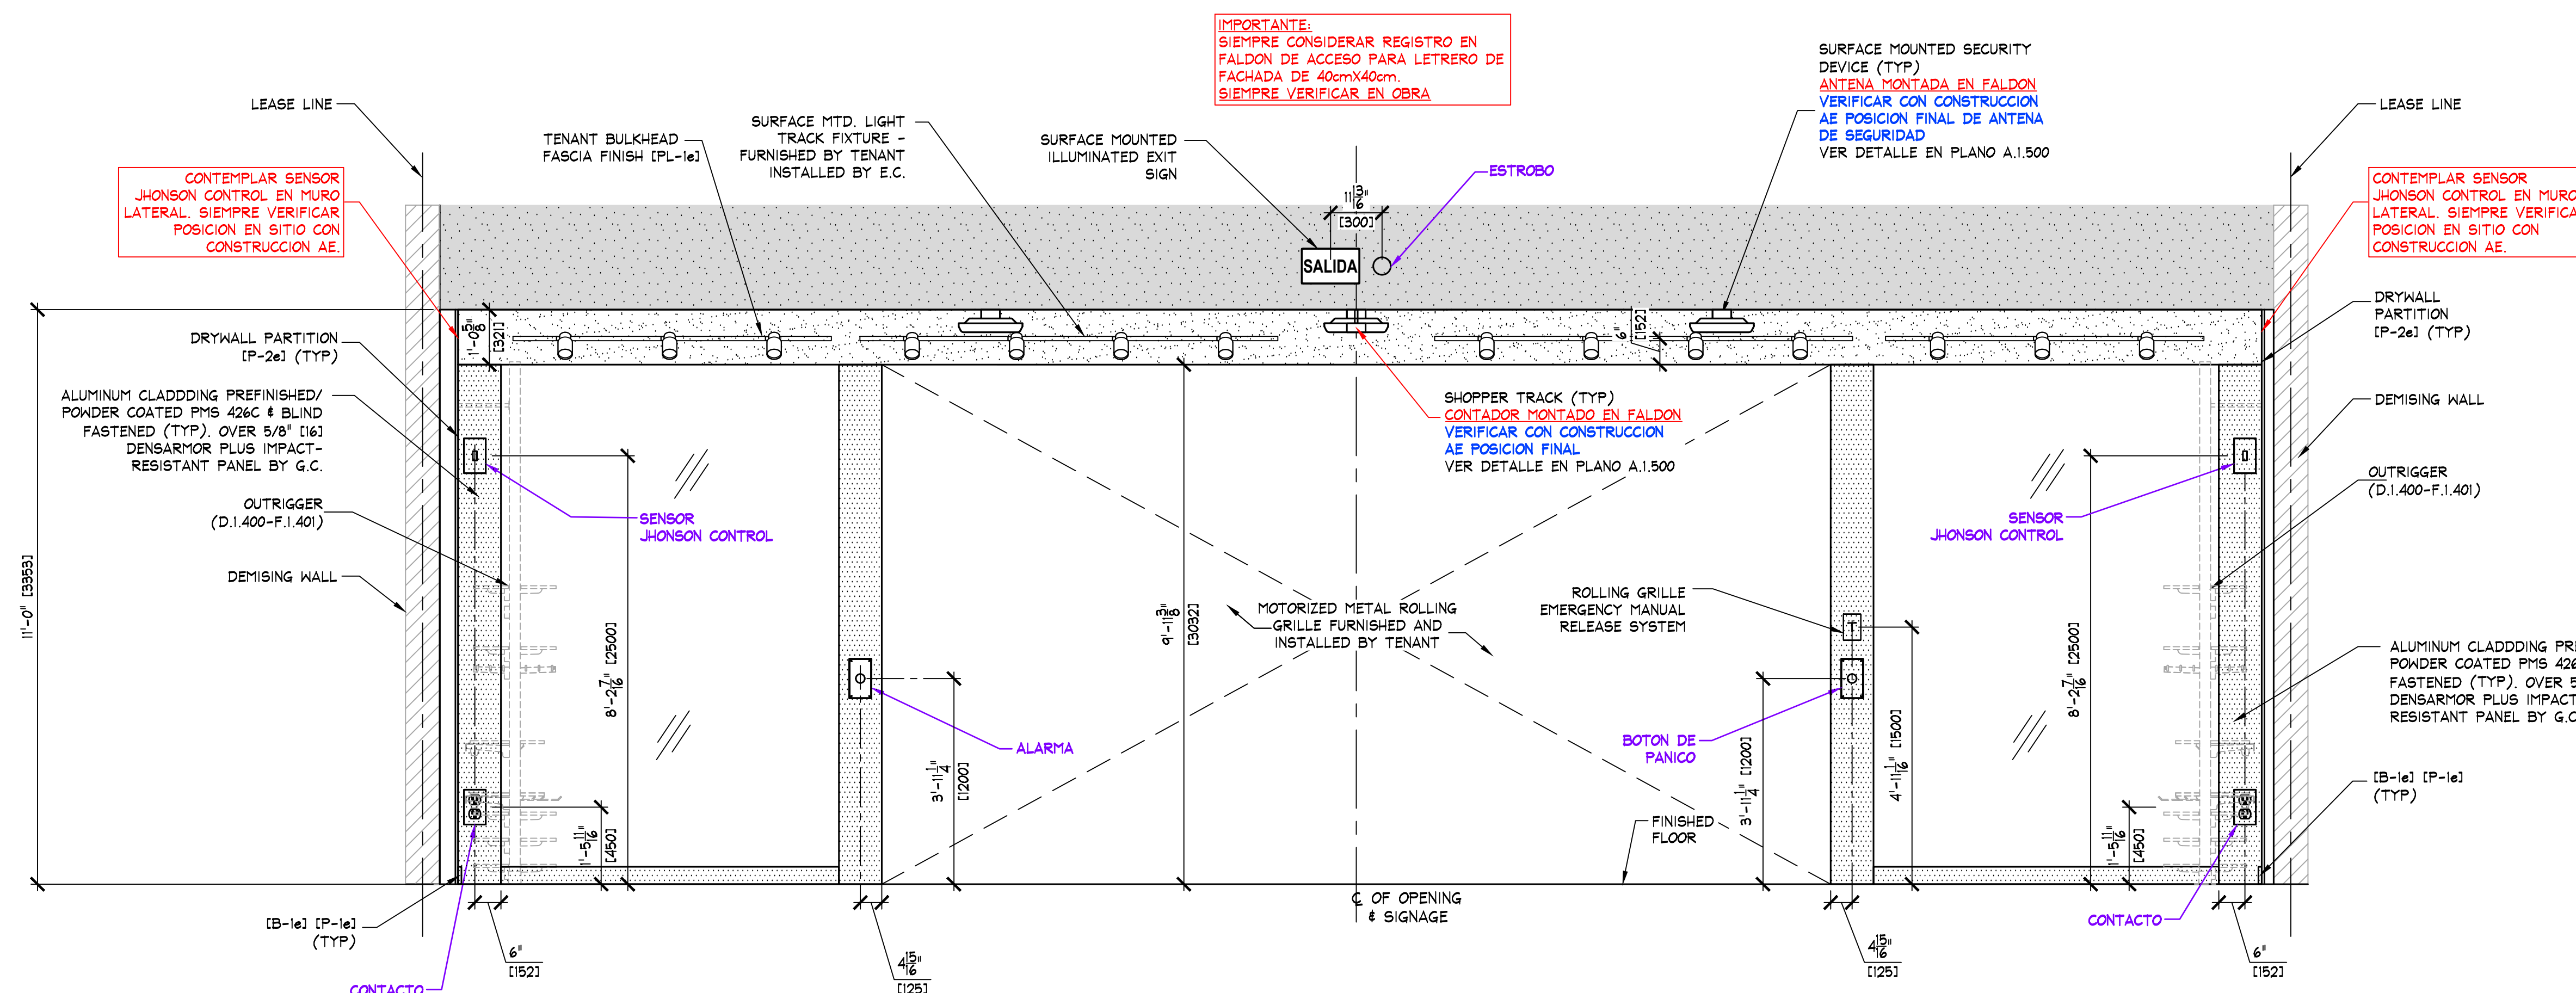

B INTERIOR ELEVATION
SCALE: 1/2" = 1'-0" (1/25)

KEY NOTES:
SIGN - FURNISHED BY SIGN CONSULTANT.
INSTALLED BY G.C. - SEE SHEET 'A.1.800'
FOR MORE INFORMATION.

NOTE:
PAINTING CONTRACTOR SHALL
CAULK ALL INSIDE WOOD CORNERS
AND JOINTS BETWEEN TRIM AND
WALL PRIOR TO PAINTING.

NOTA:
DIMENSIONES DE LETRERO DE FACHADA SERA
ACORDE A LINEAMIENTOS DE MANUAL DE PLAZA
SEGUN SE INDIQUE. SIEMPRE VERIFICAR CON AE
PREVIO A FABRICACION.

IMPORTANTE:
SIEMPRE CONSIDERAR REGISTRO EN
FALDON DE ACCESO PARA LETRERO
DE FACHADA DE 40cmx40cm.
SIEMPRE VERIFICAR EN OBRA.

ACTUALIZACION DE FACHADA POR INDICACION AE (27-OCTUBRE-2022)
ACTUALIZACION DE FACHADA POR INDICACION AE (14-OCTUBRE-2022)
PROYECTO AJUSTADO EN FALDON DE ACCESO CON REDLINES RECIBIDOS POR AE (27-SEP-2022)

IMPORTANTE:

FACHADA PENDIENTE DE REVISION CON CENTRO COMERCIAL, NO SE CUENTA CON INDICACIONES DE MANUAL DE ADAPTACIONES.

- VERIFICAR DISEÑO DE FACHADA CON MANUAL DE CENTRO COMERCIAL.
- VERIFICAR EN SITIO MEDIDAS PREVIO A TRABAJOS DE FACHADA, ASI COMO APROBACION POR PARTE DE AE Y C.C.

AMERICAN EAGLE

THINK ARCHITECTURE S.A. DE C.V.
Descartes 93, 1er piso Col. Anzures
Miguel Hidalgo C.P.11550 México
THINK
AMERICAN EAGLE OUTFITTERS, INC.
77 Hot Metal Street
Pittsburgh, PA 15203
(412)452-3300

STOREFRONT ELEVATIONS

AMERICAN EAGLE OUTFITTERS
Forum Tec C.C.
Tepic, Nayarit

Space #: FB16





Store No.

9266

Drawn by:



Drawing No.

A.1.300

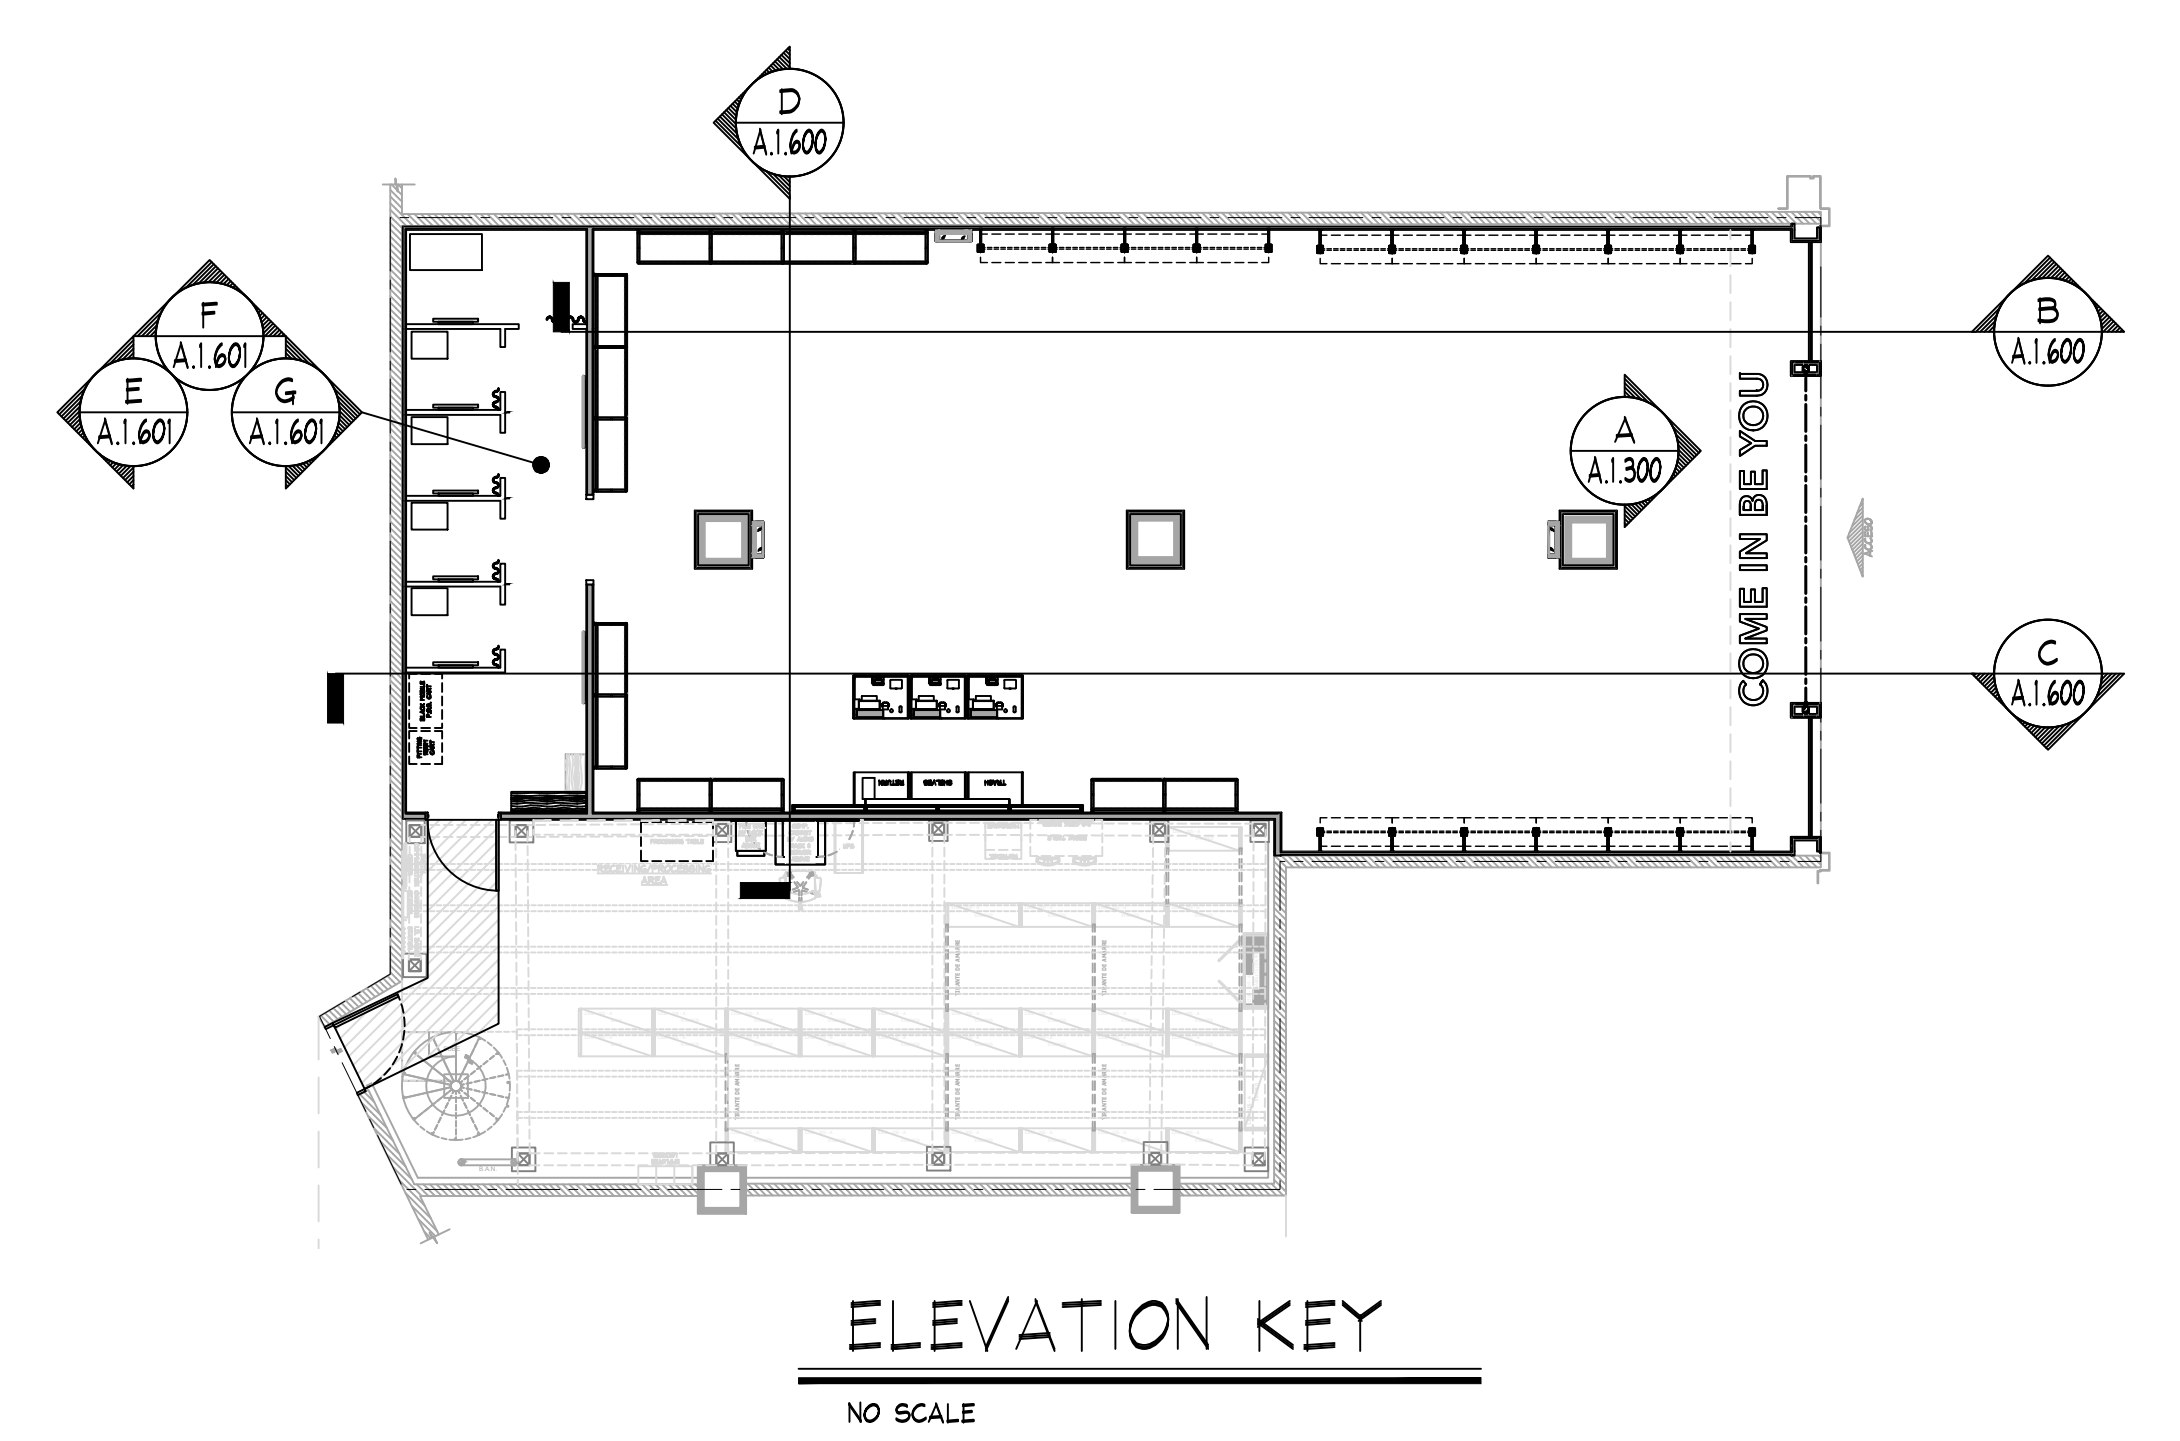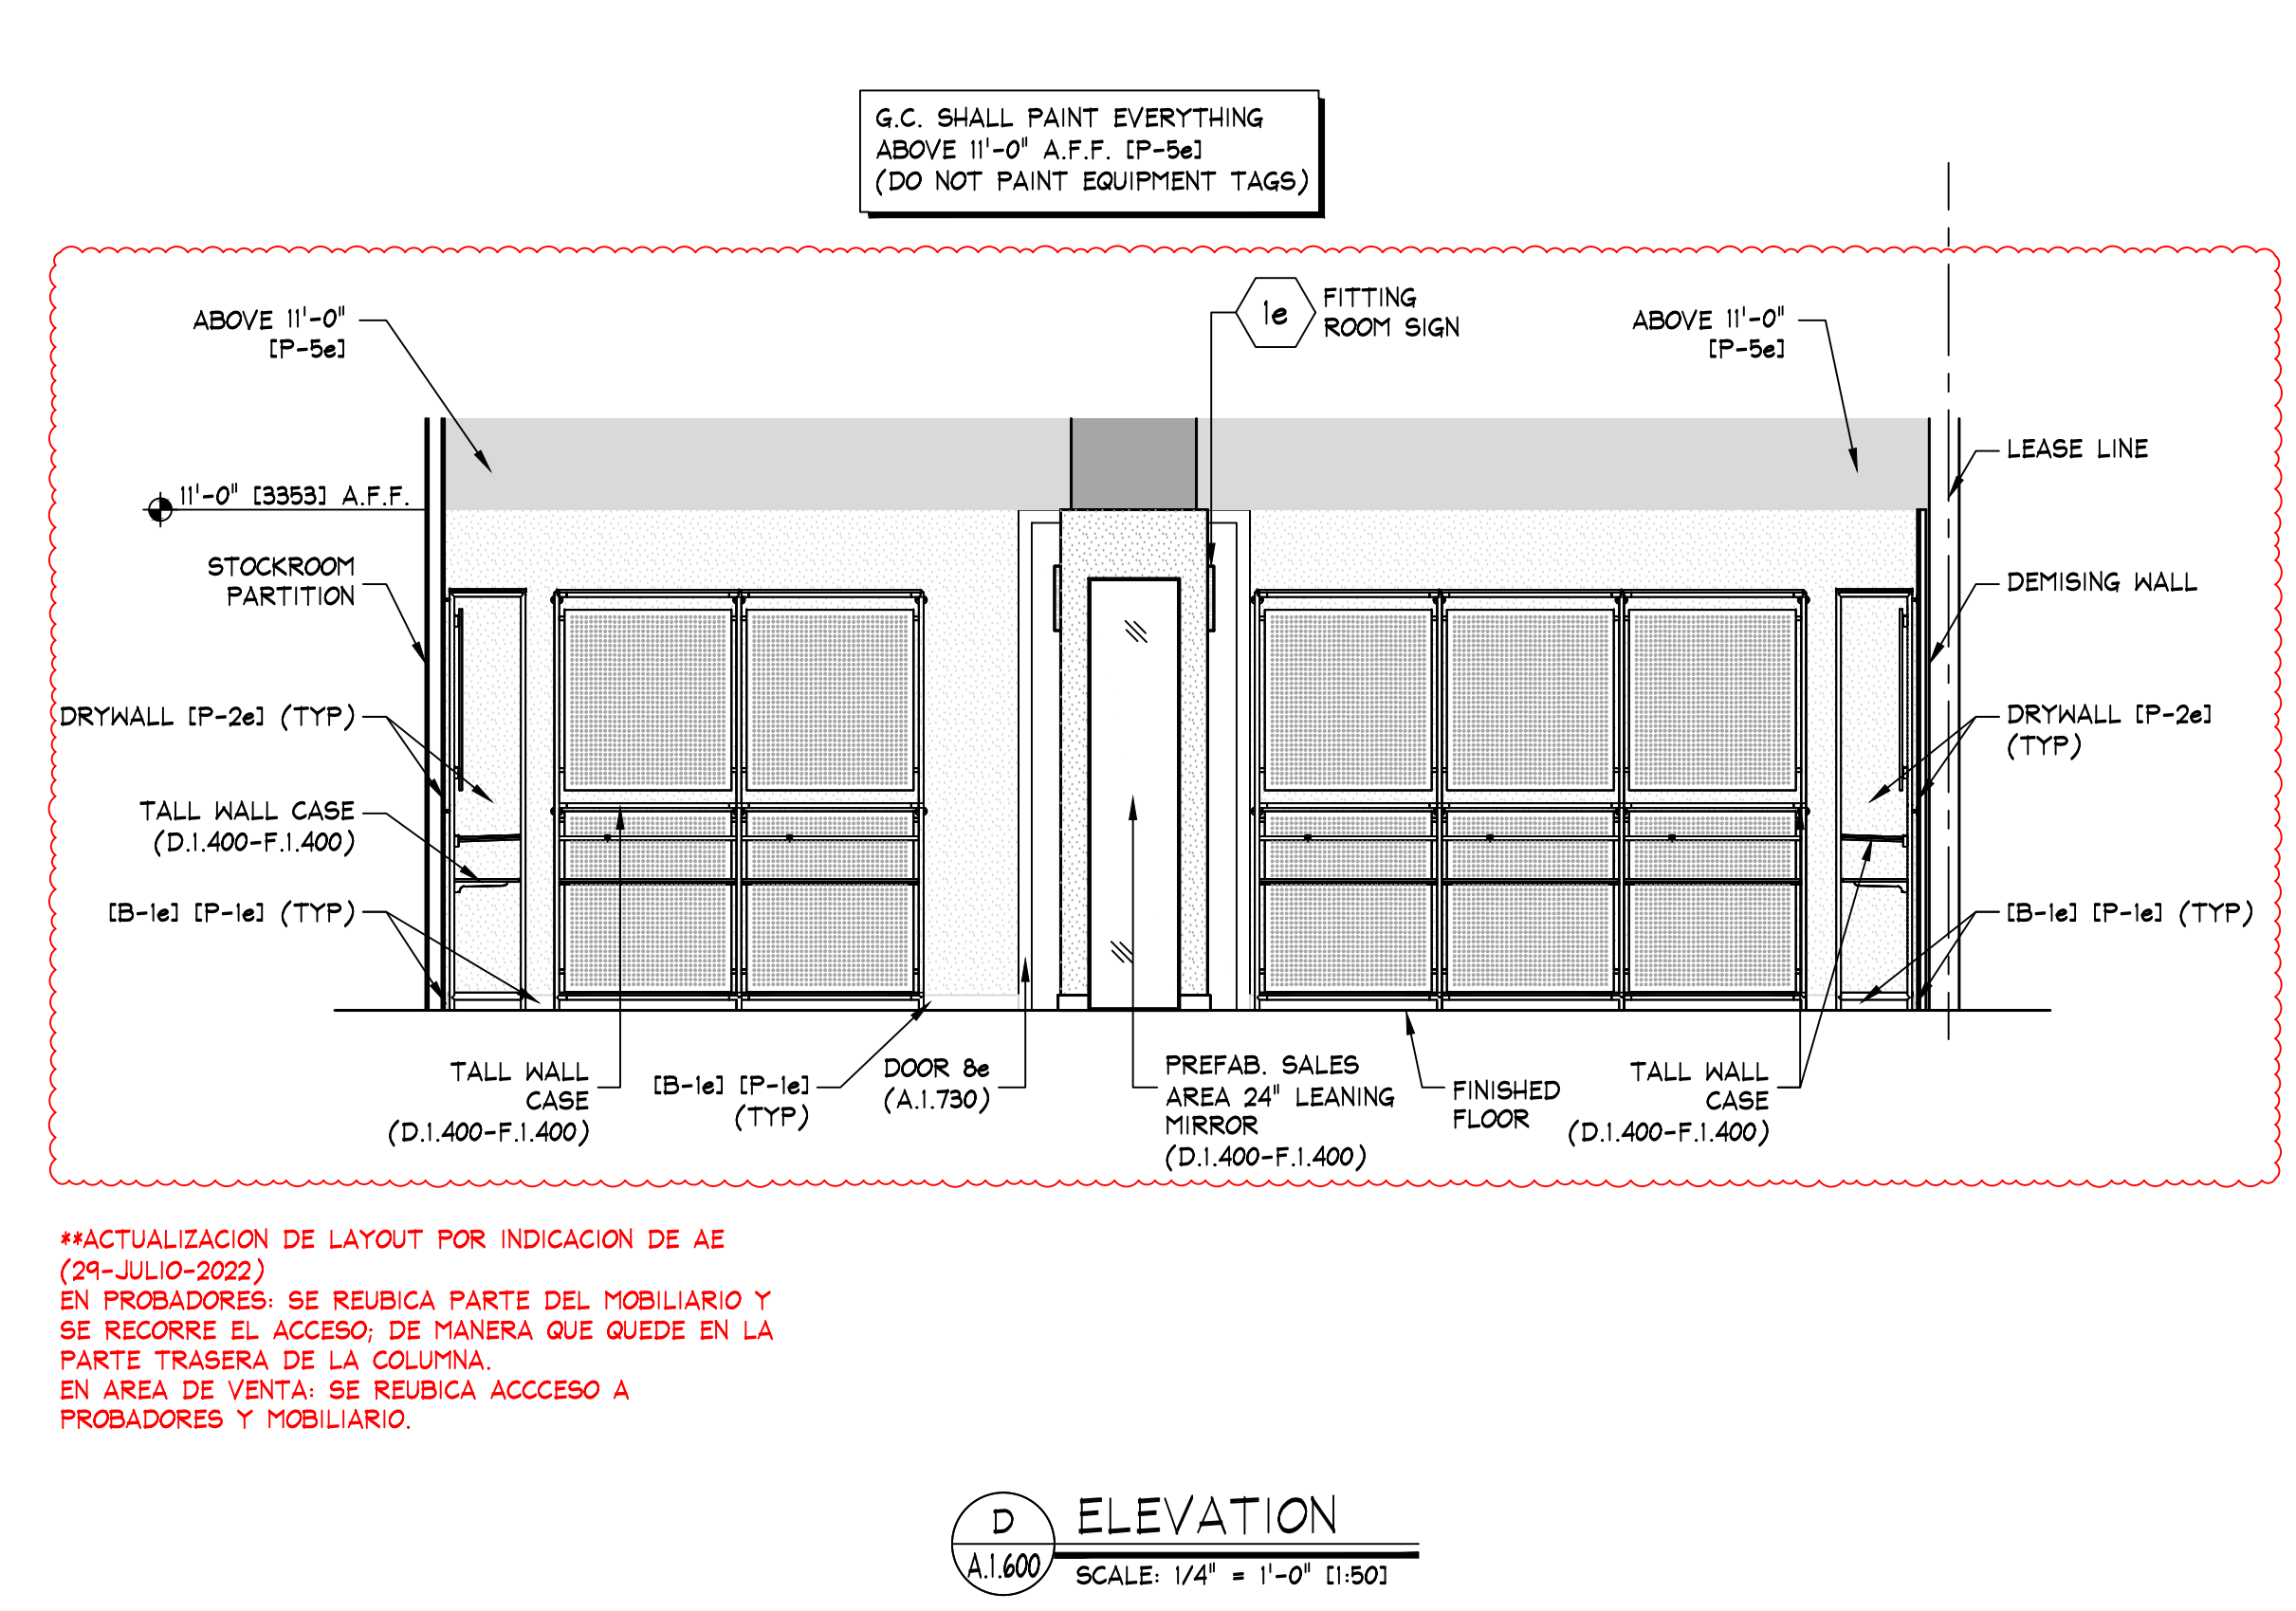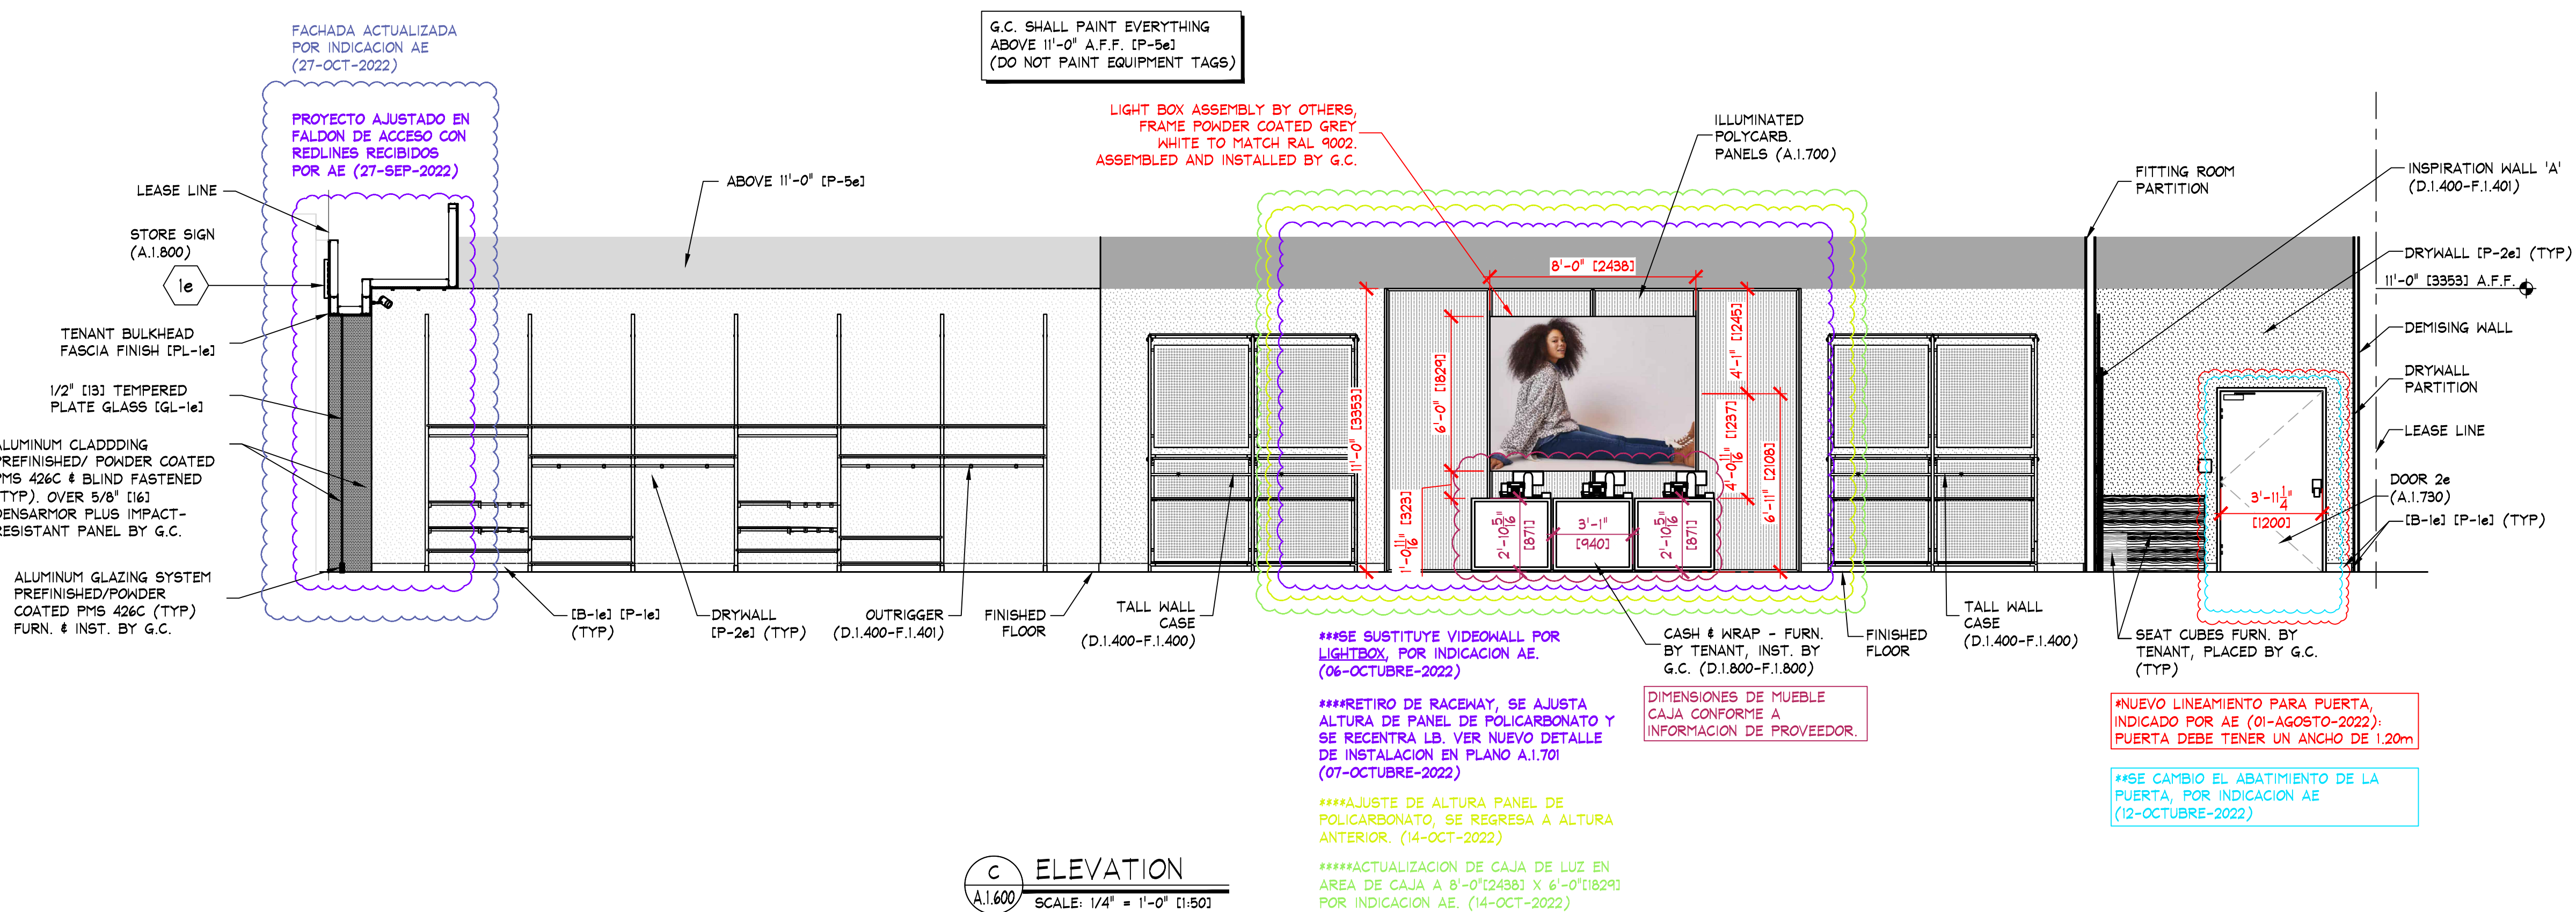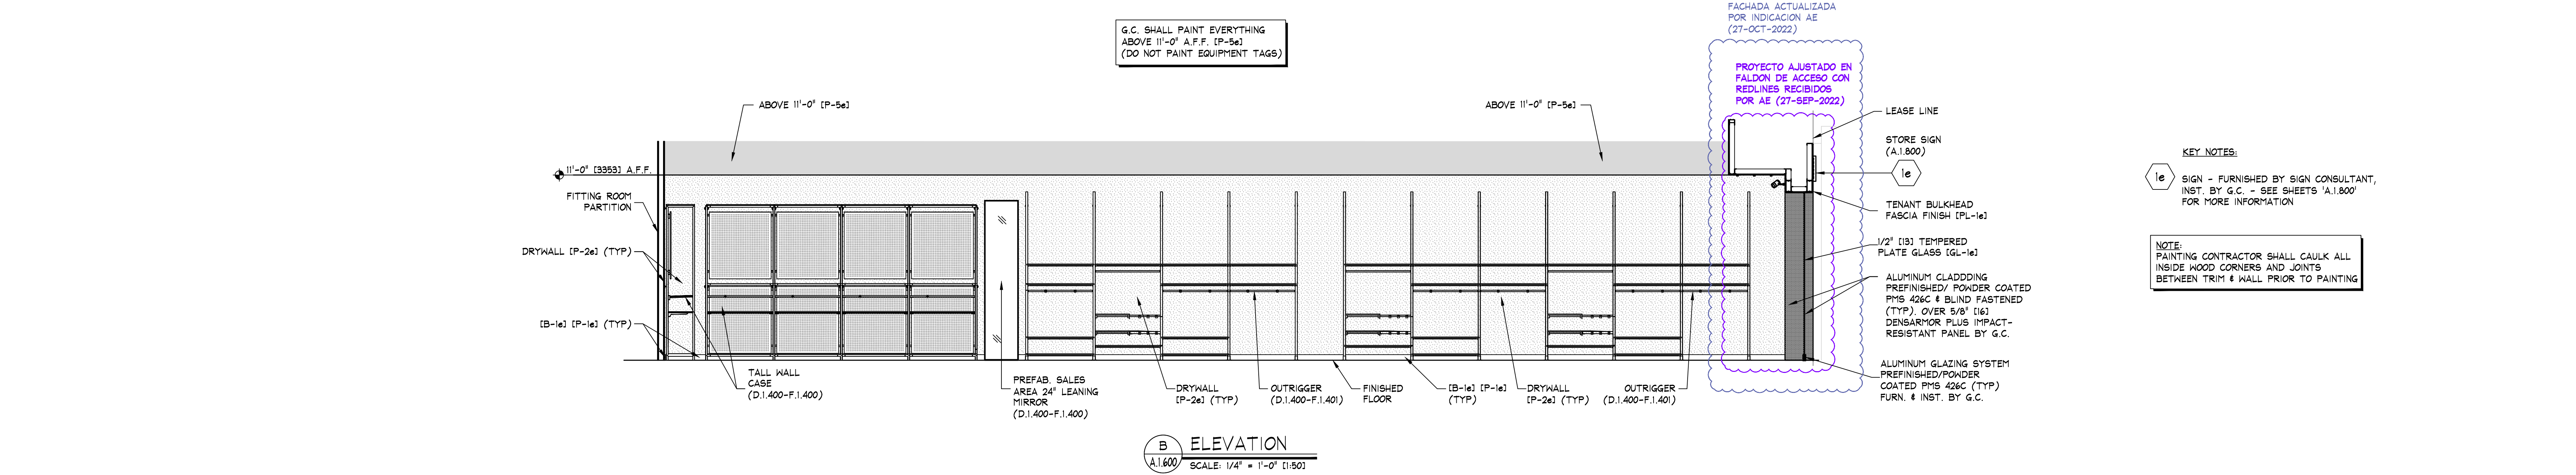

NOTA:

- PROBADORES SERAN REALIZADOS EN SITIO, VERIFICAR CON AE CONSTRUCCION, MATERIALES Y EJECUCION.

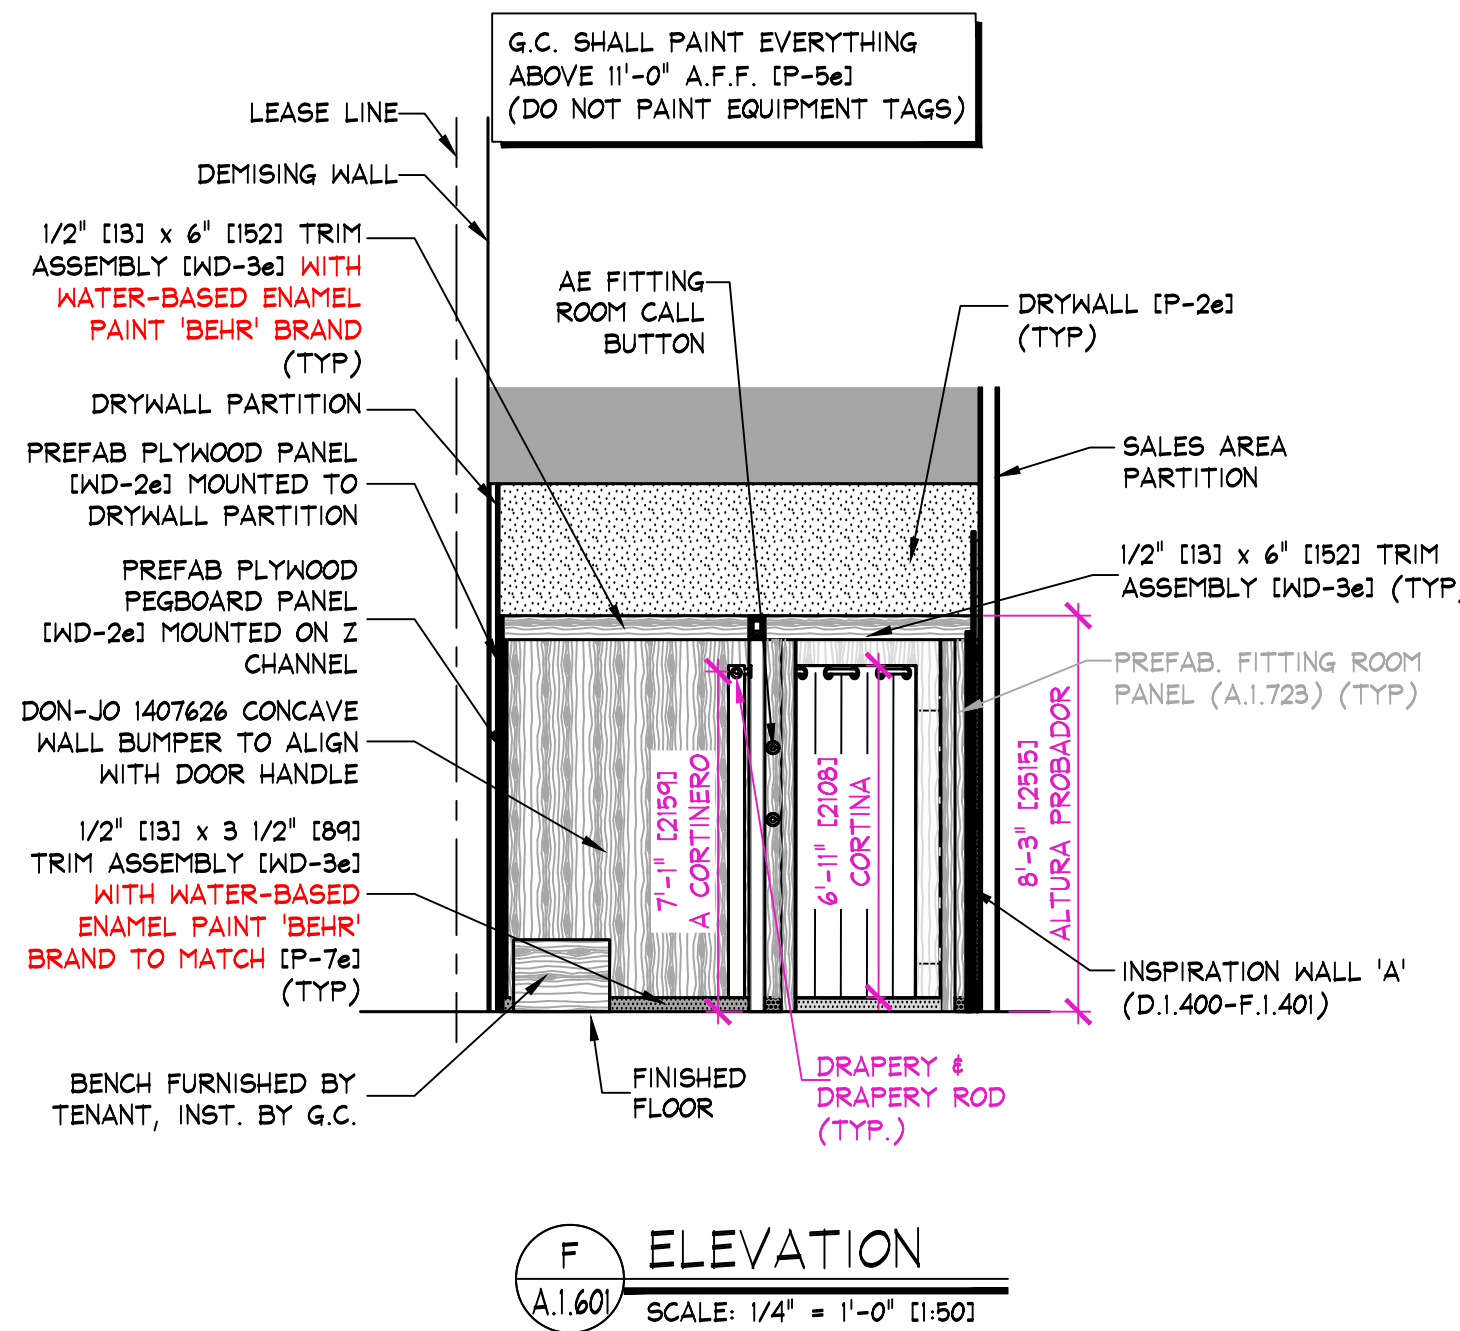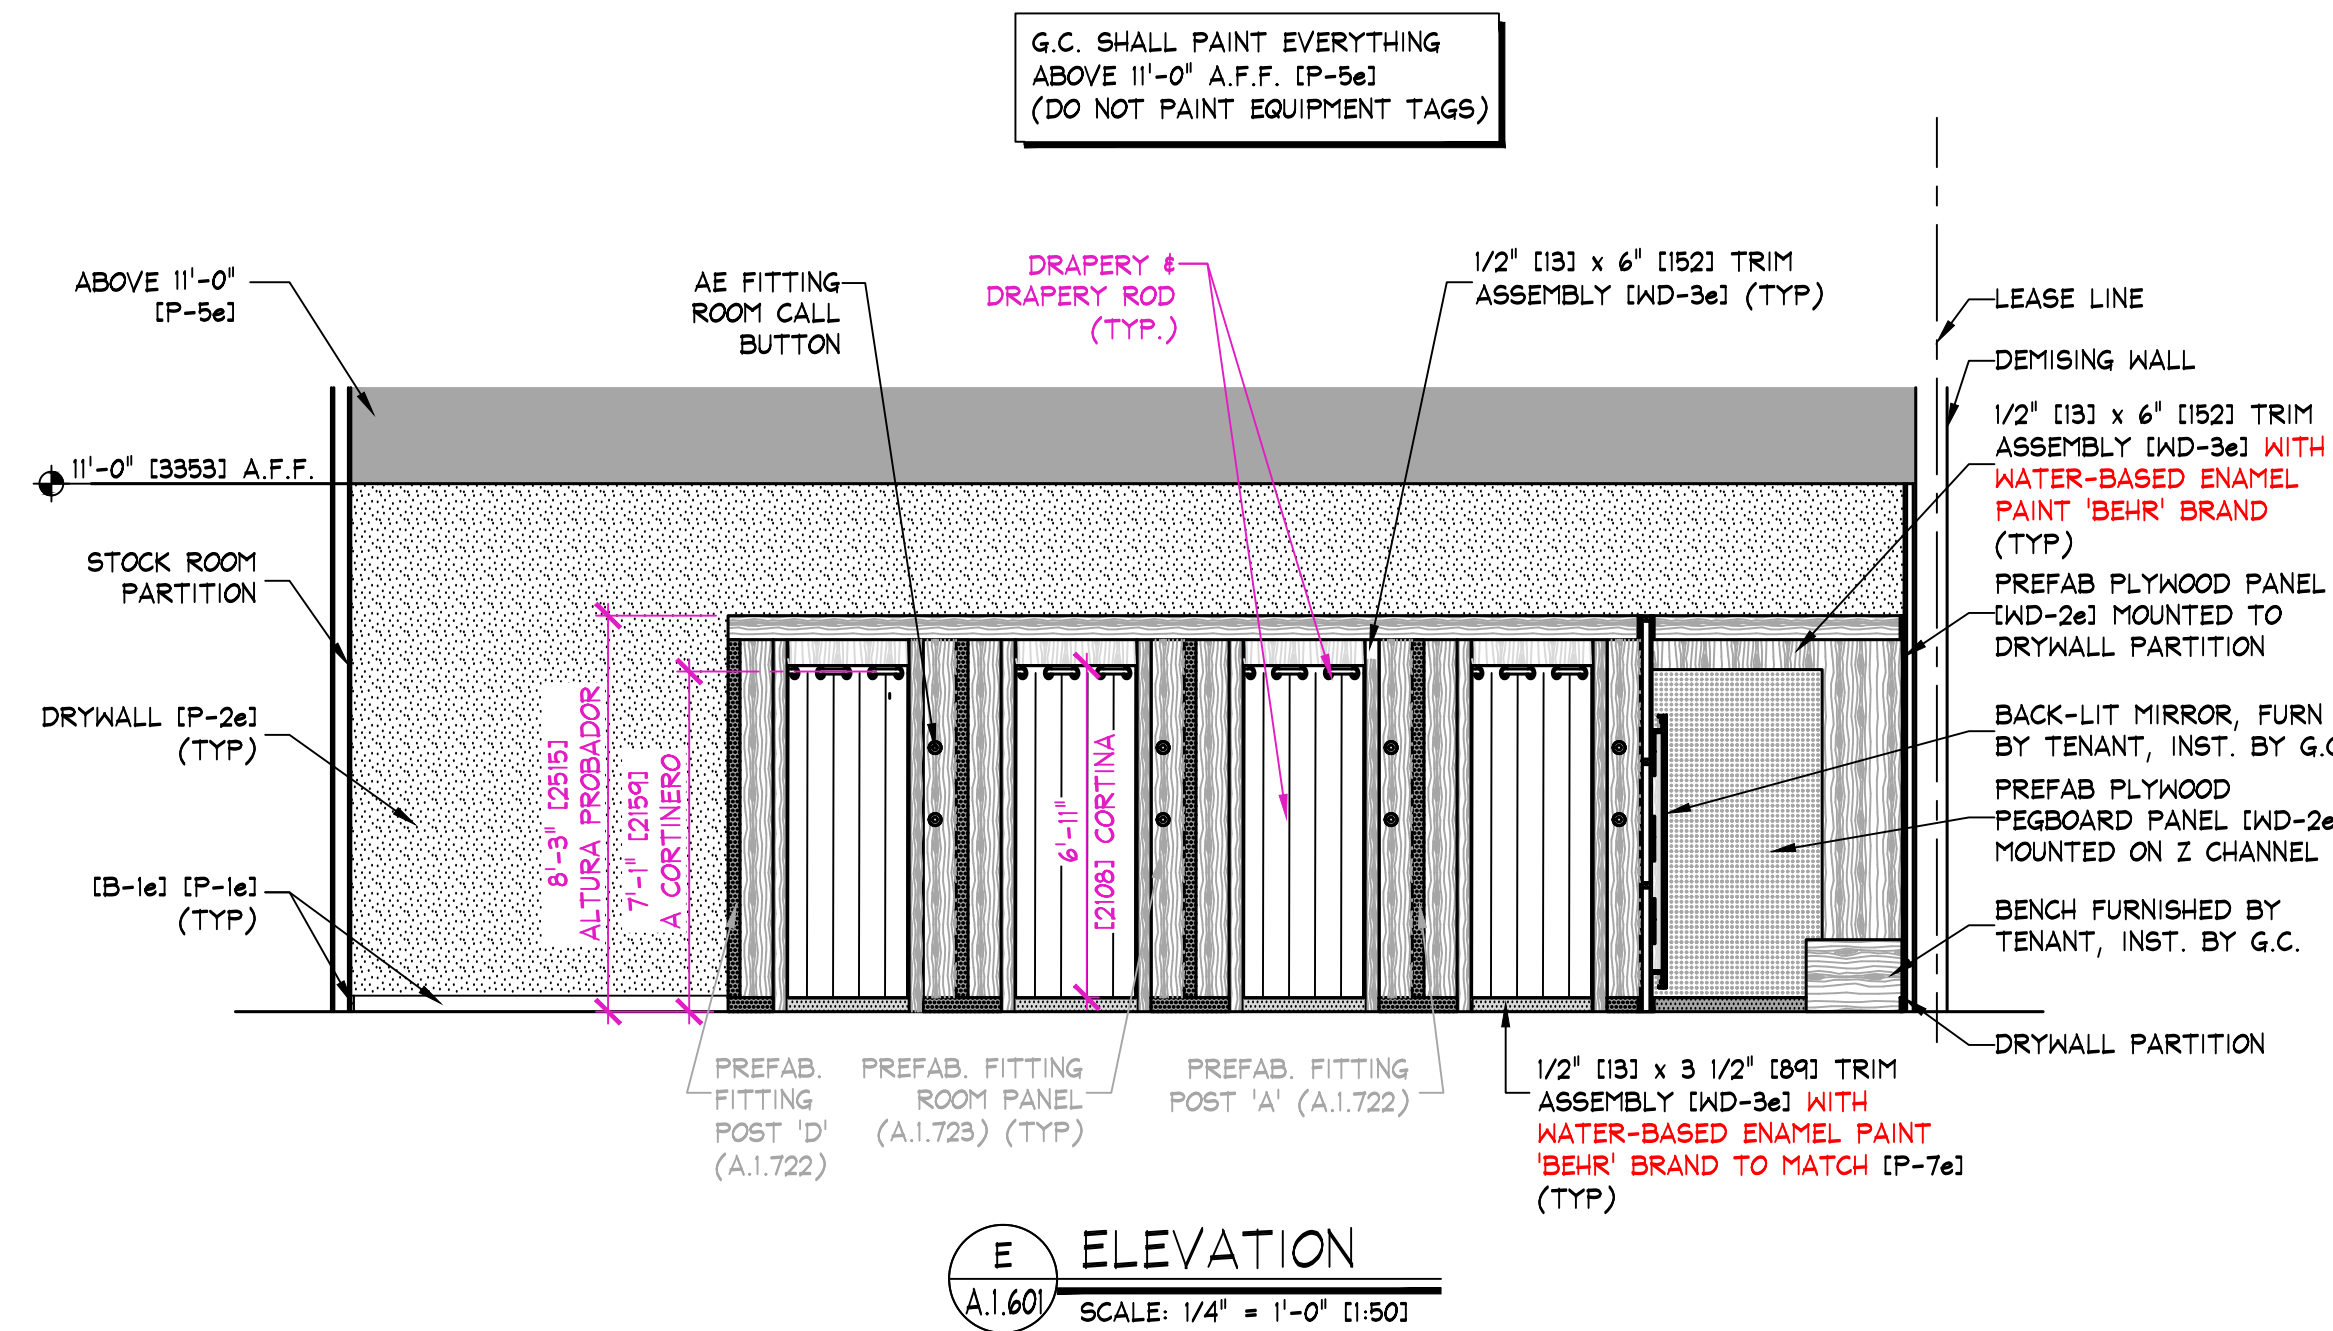


KEY NOTES:

1e SIGN - FURNISHED BY SIGN CONSULTANT, INST. BY G.C. - SEE SHEETS 'A.1.800' FOR MORE INFORMATION.

NOTE: PAINTING CONTRACTOR SHALL CAULK ALL INSIDE HOOD CORNERS AND JOINTS BETWEEN TRIM & WALL PRIOR TO PAINTING.

E ELEVATION
A.1.601 SCALE: 1/4" = 1'-0" (1:50)

F ELEVATION
A.1.601 SCALE: 1/4" = 1'-0" (1:50)

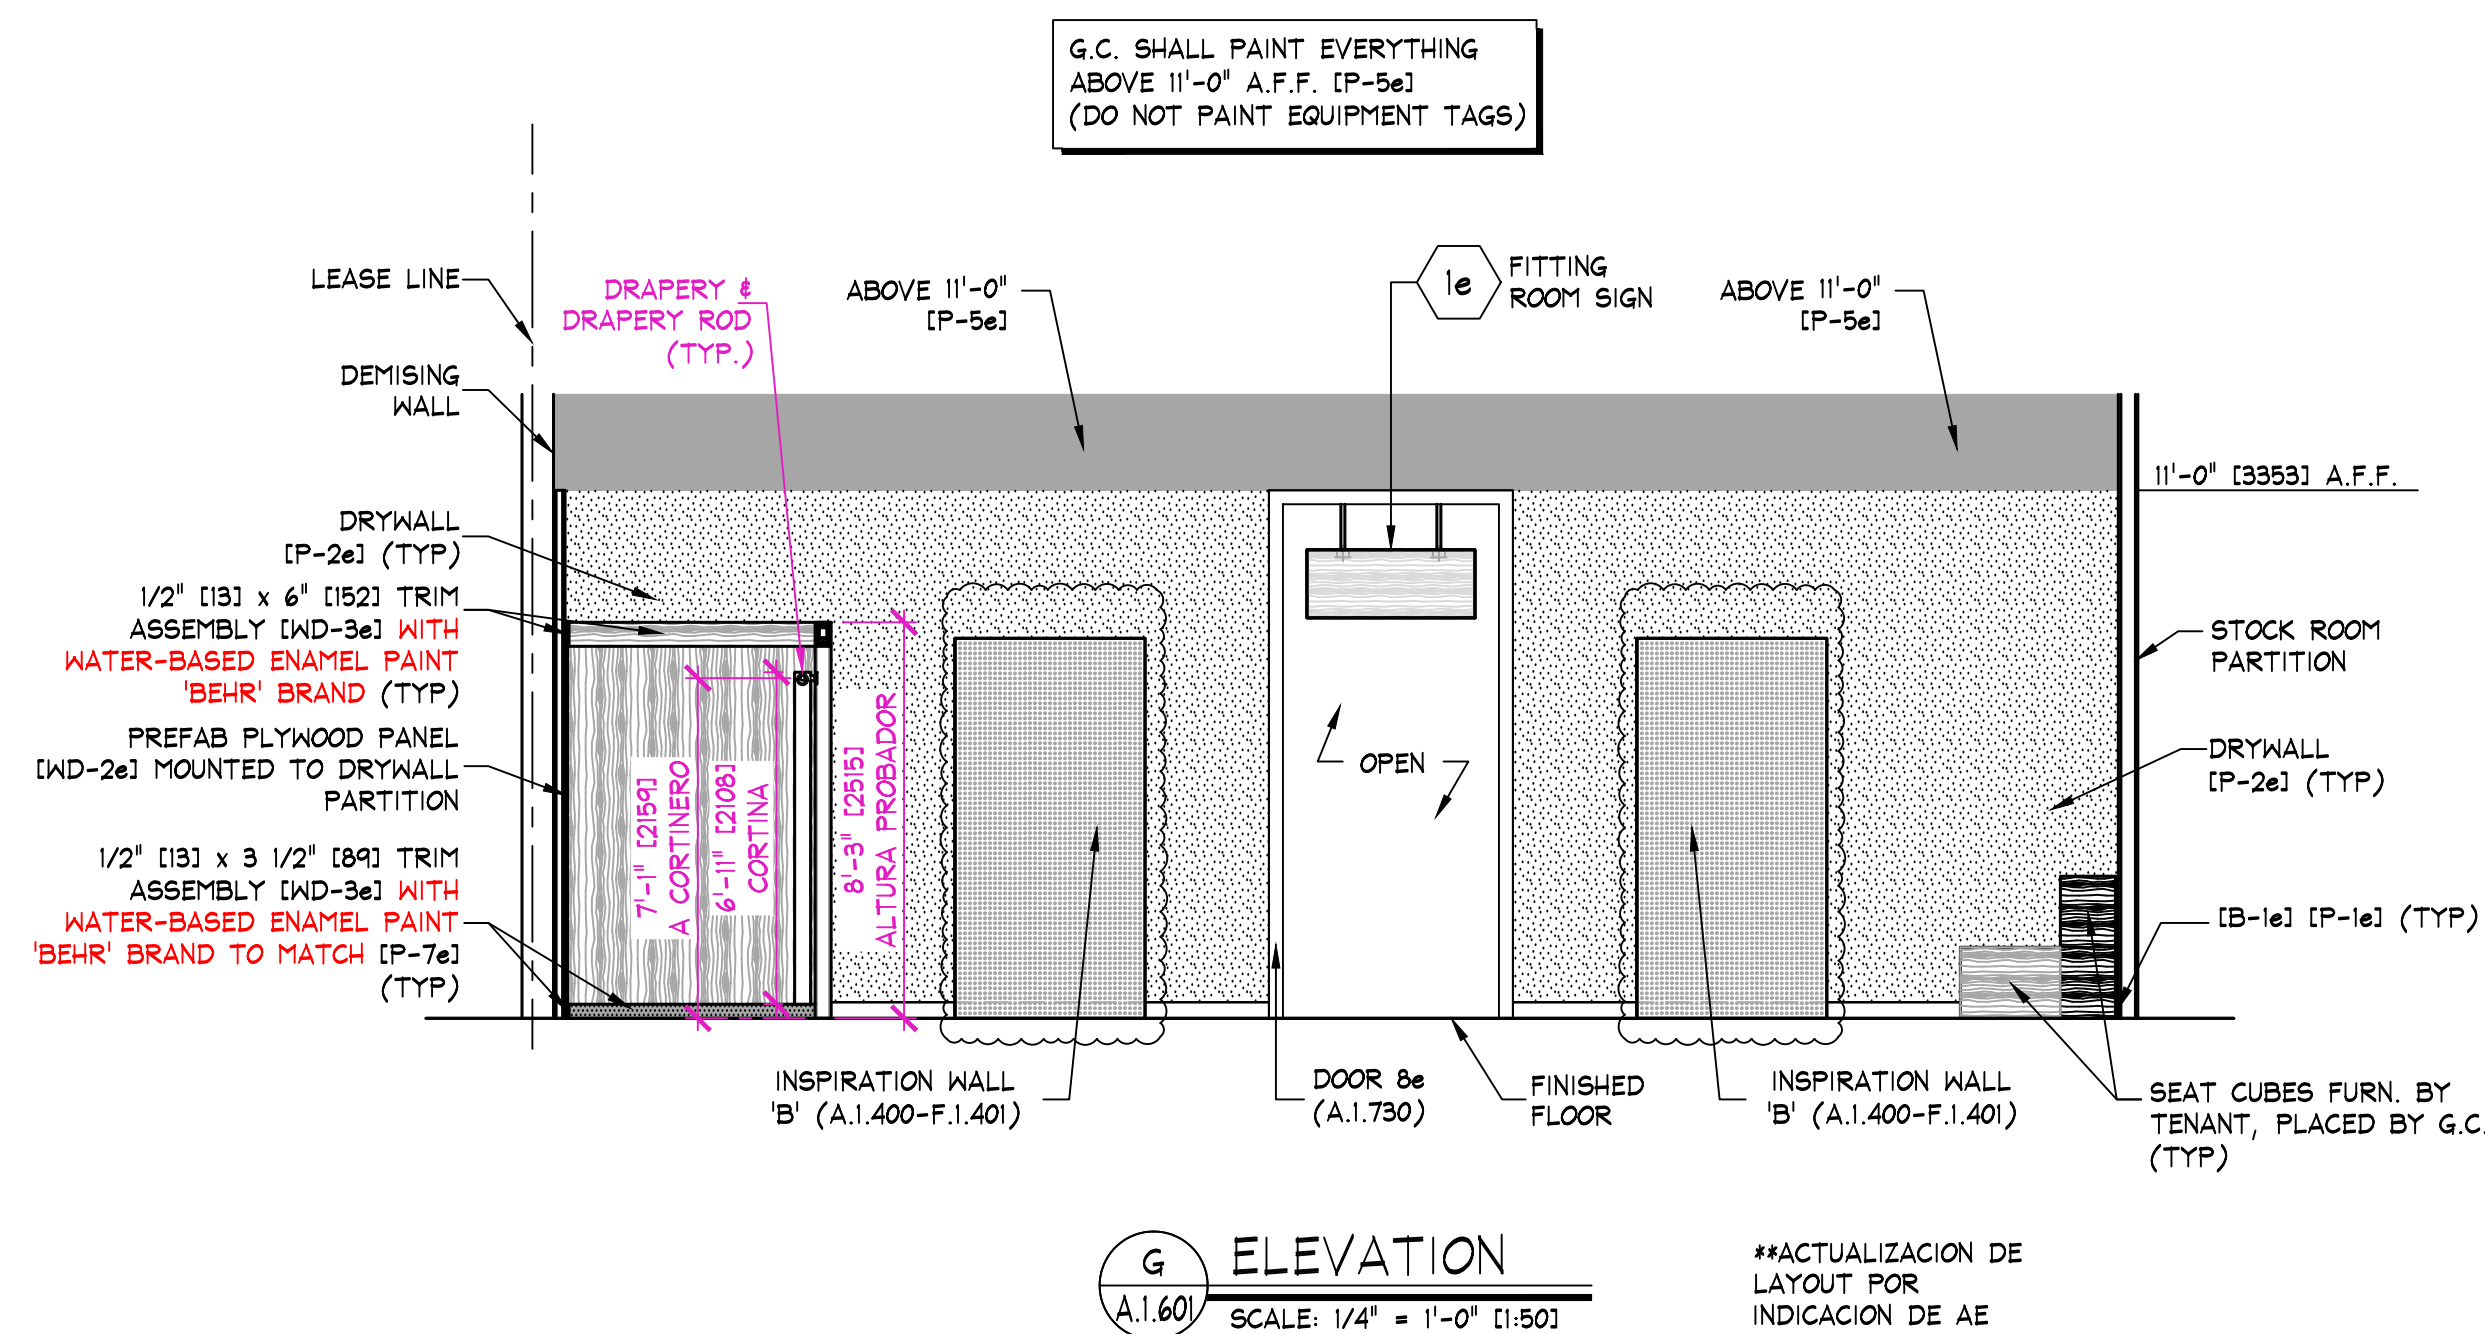

G ELEVATION
A.1.601 SCALE: 1/4" = 1'-0" (1:50)

**ACTUALIZACION DE LAYOUT POR INDICACION DE AE (16-AGOSTO-2022)

**ACTUALIZACION DE LAYOUT POR INDICACION DE AE (29-JULIO-2022)
EN PROBADORES: SE REUBICA PARTE DEL MOBILIARIO Y SE RECORRE EL ACCESO, DE MANERA QUE QUEDA EN LA PARTE TRASERA DE LA COLUMNA.
**ACTUALIZACION DE LAYOUT POR INDICACION DE AE (23-SEPTIEMBRE-2022):
LOS PROBADORES PARA ESTE PROYECTO SERAN REALIZADOS EN SITIO.
SE QUITA PUERTA DE PROBADORES Y SE COLOCA CORTINERO, POR INDICACIONES AE

NOTA:

- PROBADORES SERAN REALIZADOS EN SITIO, VERIFICAR CON AE CONSTRUCCION, MATERIALES Y EJECUCION.

