


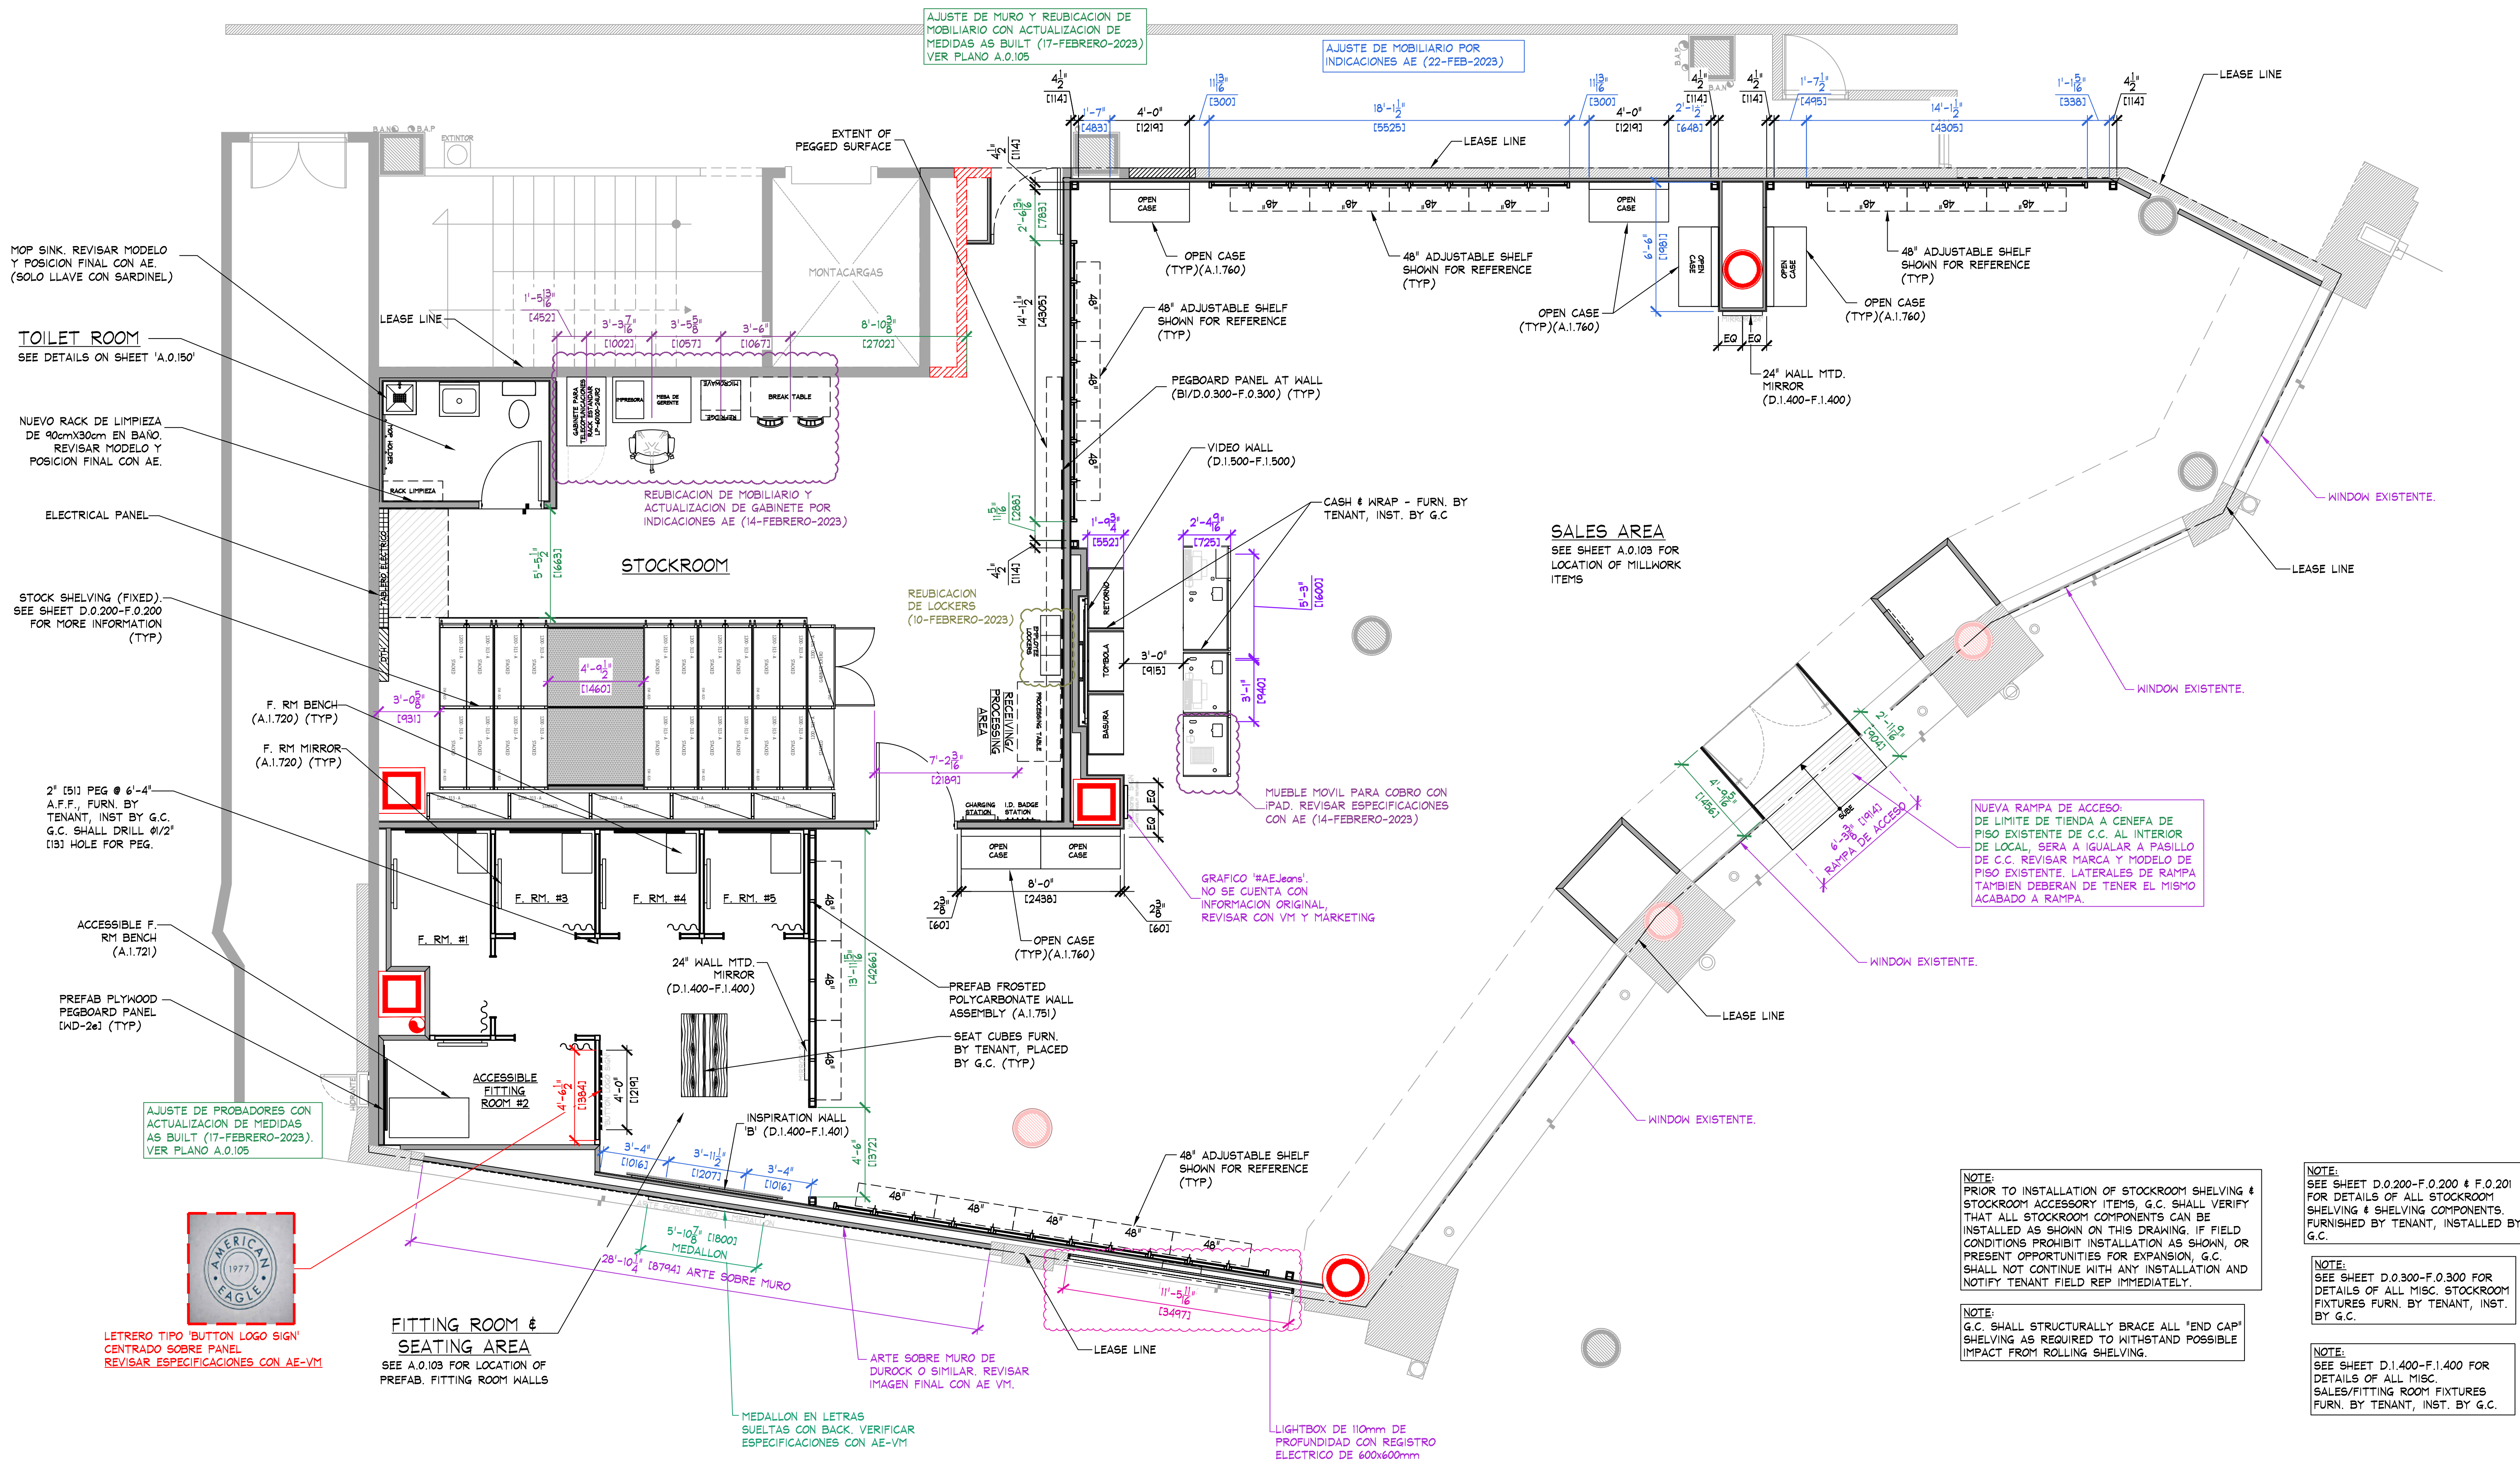

FIXTURE PLAN
SCALE: 1/4" = 1'-0" (1:50)

AREA ANALYSIS			
AREA	m ²	FT ²	%
AE SALES AREA	204.8	2,205	57%
AE FITTING ROOMS	33	355	4%
AERIE SALES AREA	0	0	0%
AERIE FITTING ROOMS	0	0	0%
STOCK ROOM	69.6	749	19%
TOILET ROOM	4.6	50	1%
EGRESS CORRIDOR	0	0	0%
AE DISPLAY	19.5	210	5%
AERIE DISPLAY	0	0	0%
OTHER	0	0	0%
UNUSED	28.3	305	8%
TOTAL	359.9	3874	100%

ACTUALIZACION DE TABLA POR
AJUSTE DE LAYOUT (22-FEB-2023)

MANUAL DE CENTRO COMERCIAL:

Las losas de Centro Comercial Paseo Altozano están construidas a base de losas doble "T" preforzadas y coladas en sitio, de éstas únicamente se podrán colgantar plafones e instalaciones que no tengan un peso mayor a 30 Kg/m² en total. VERIFICAR SISTEMA CONSTRUCTIVO DE LAS LOSAS.

Los anclajes y fijaciones en las losas son fáciles de realizar y como en cualquier otro sistema estarán en función de las cargas a soportar. Para pequeñas y medianas cargas de ductos y tubos se pueden emplear sujetadores típicos con anclajes de expansión, tornillos "T" o insertos "T".

Las capacidades de estos anclajes serán definidas por el correspondiente fabricante de estos. Para cargas mayores se pueden emplear tornillos atravesando las losas. Para ello se consultará a la empresa que El Centro Comercial Paseo Altozano indique con cargo al Arrendatario.

En todos los casos se tomarán las medidas de seguridad necesarias y suficientes para la realización de los trabajos antes mencionados. En ningún caso se permitirán disparos a través de sistema de pistola en la perforación de la losa.

NOTE:


- ALL SUPPORT TRACK AND RELATED COMPONENTS, REQUIRED TO SUPPORT TRACK LIGHTING FIXTURES ONLY, ARE TO BE FURNISHED BY TENANT & INSTALLED BY G.C. - G.C. SHALL ENSURE THAT ALL SUPPORT TRACK IS INSTALLED WITH FIRST CLASS WORKMANSHIP, LEVEL, STRAIGHT, & ALIGNED.
- ALL OTHER EQUIPMENT/COMPONENT SUPPORTS (UNISTRUT, CLAMPS, NUTS, BOLTS, WASHERS, ETC.) FURN. & INST. BY G.C.

KEY NOTES:

- 2a STOCKROOM CEILING - NO CEILING, UNLESS REQUIRED BY LANDLORD OR LOCAL BUILDING CODES - (CCT-2a). SUSPENSION SYSTEM SHALL BE AS MANUFACTURED BY USG INTERIORS, INC. DOWN CEILING SUSPENSION DXL SERIES, WHITE EXPOSED 2'x4' GRID SYSTEM.
- 3a SIGN - FURNISHED BY SIGN CONSULTANT, INSTALLED BY G.C. SEE SHEET A.1.800 FOR MORE INFORMATION. VERIFICAR CON AE PREVIO A FABRICACION TEMPERATURA, DIMENSION Y TIPOGRAFIA.
- 4a ACCESS PANELS - G.C. SHALL FURNISH AND INSTALL ACCESS PANELS FOR ABOVE CEILING MAINTENANCE. ACCESS PANELS SHALL BE 600X600 AS MANUFACTURED BY WIND-LOCK, STEALTH PANEL #TR-AP024 ALUCOBOND NEGRO O SIMILAR A IGUALAR A PMS 426C (TYP). G.C. SHALL FURNISH AND INSTALL ACCESS PANELS FOR ALL NEW AND EXISTING ABOVE CEILING COMPONENTS REQUIRING MAINTENANCE ACCESS (e.g. HVAC UNIT CONTROLS, SHUT OFF VALVES, DAMPER CONTROLS, J-BOXES, ETC. - LANDLORD AND/OR TENANT PROVIDED - G.C. TO VERIFY IN THE FIELD). COORDINATE ALL LOCATIONS WITH TENANT FIELD REPRESENTATIVE.

NOTE:

ALL COMPONENTS REQUIRED TO SUPPORT AND INSTALL THE SUSPENDED CEILING SYSTEM (WHETHER DRYWALL AND/OR ACOUSTIC TILE), ARE TO BE FURNISHED AND INSTALLED BY G.C. - G.C. SHALL CONSULT WITH MALL/BUILDING DEPARTMENT TO DETERMINE REQUIRED METHODS FOR SUPPORTING CEILING FROM MALL STRUCTURE, PRIOR TO SUBMITTING BID.

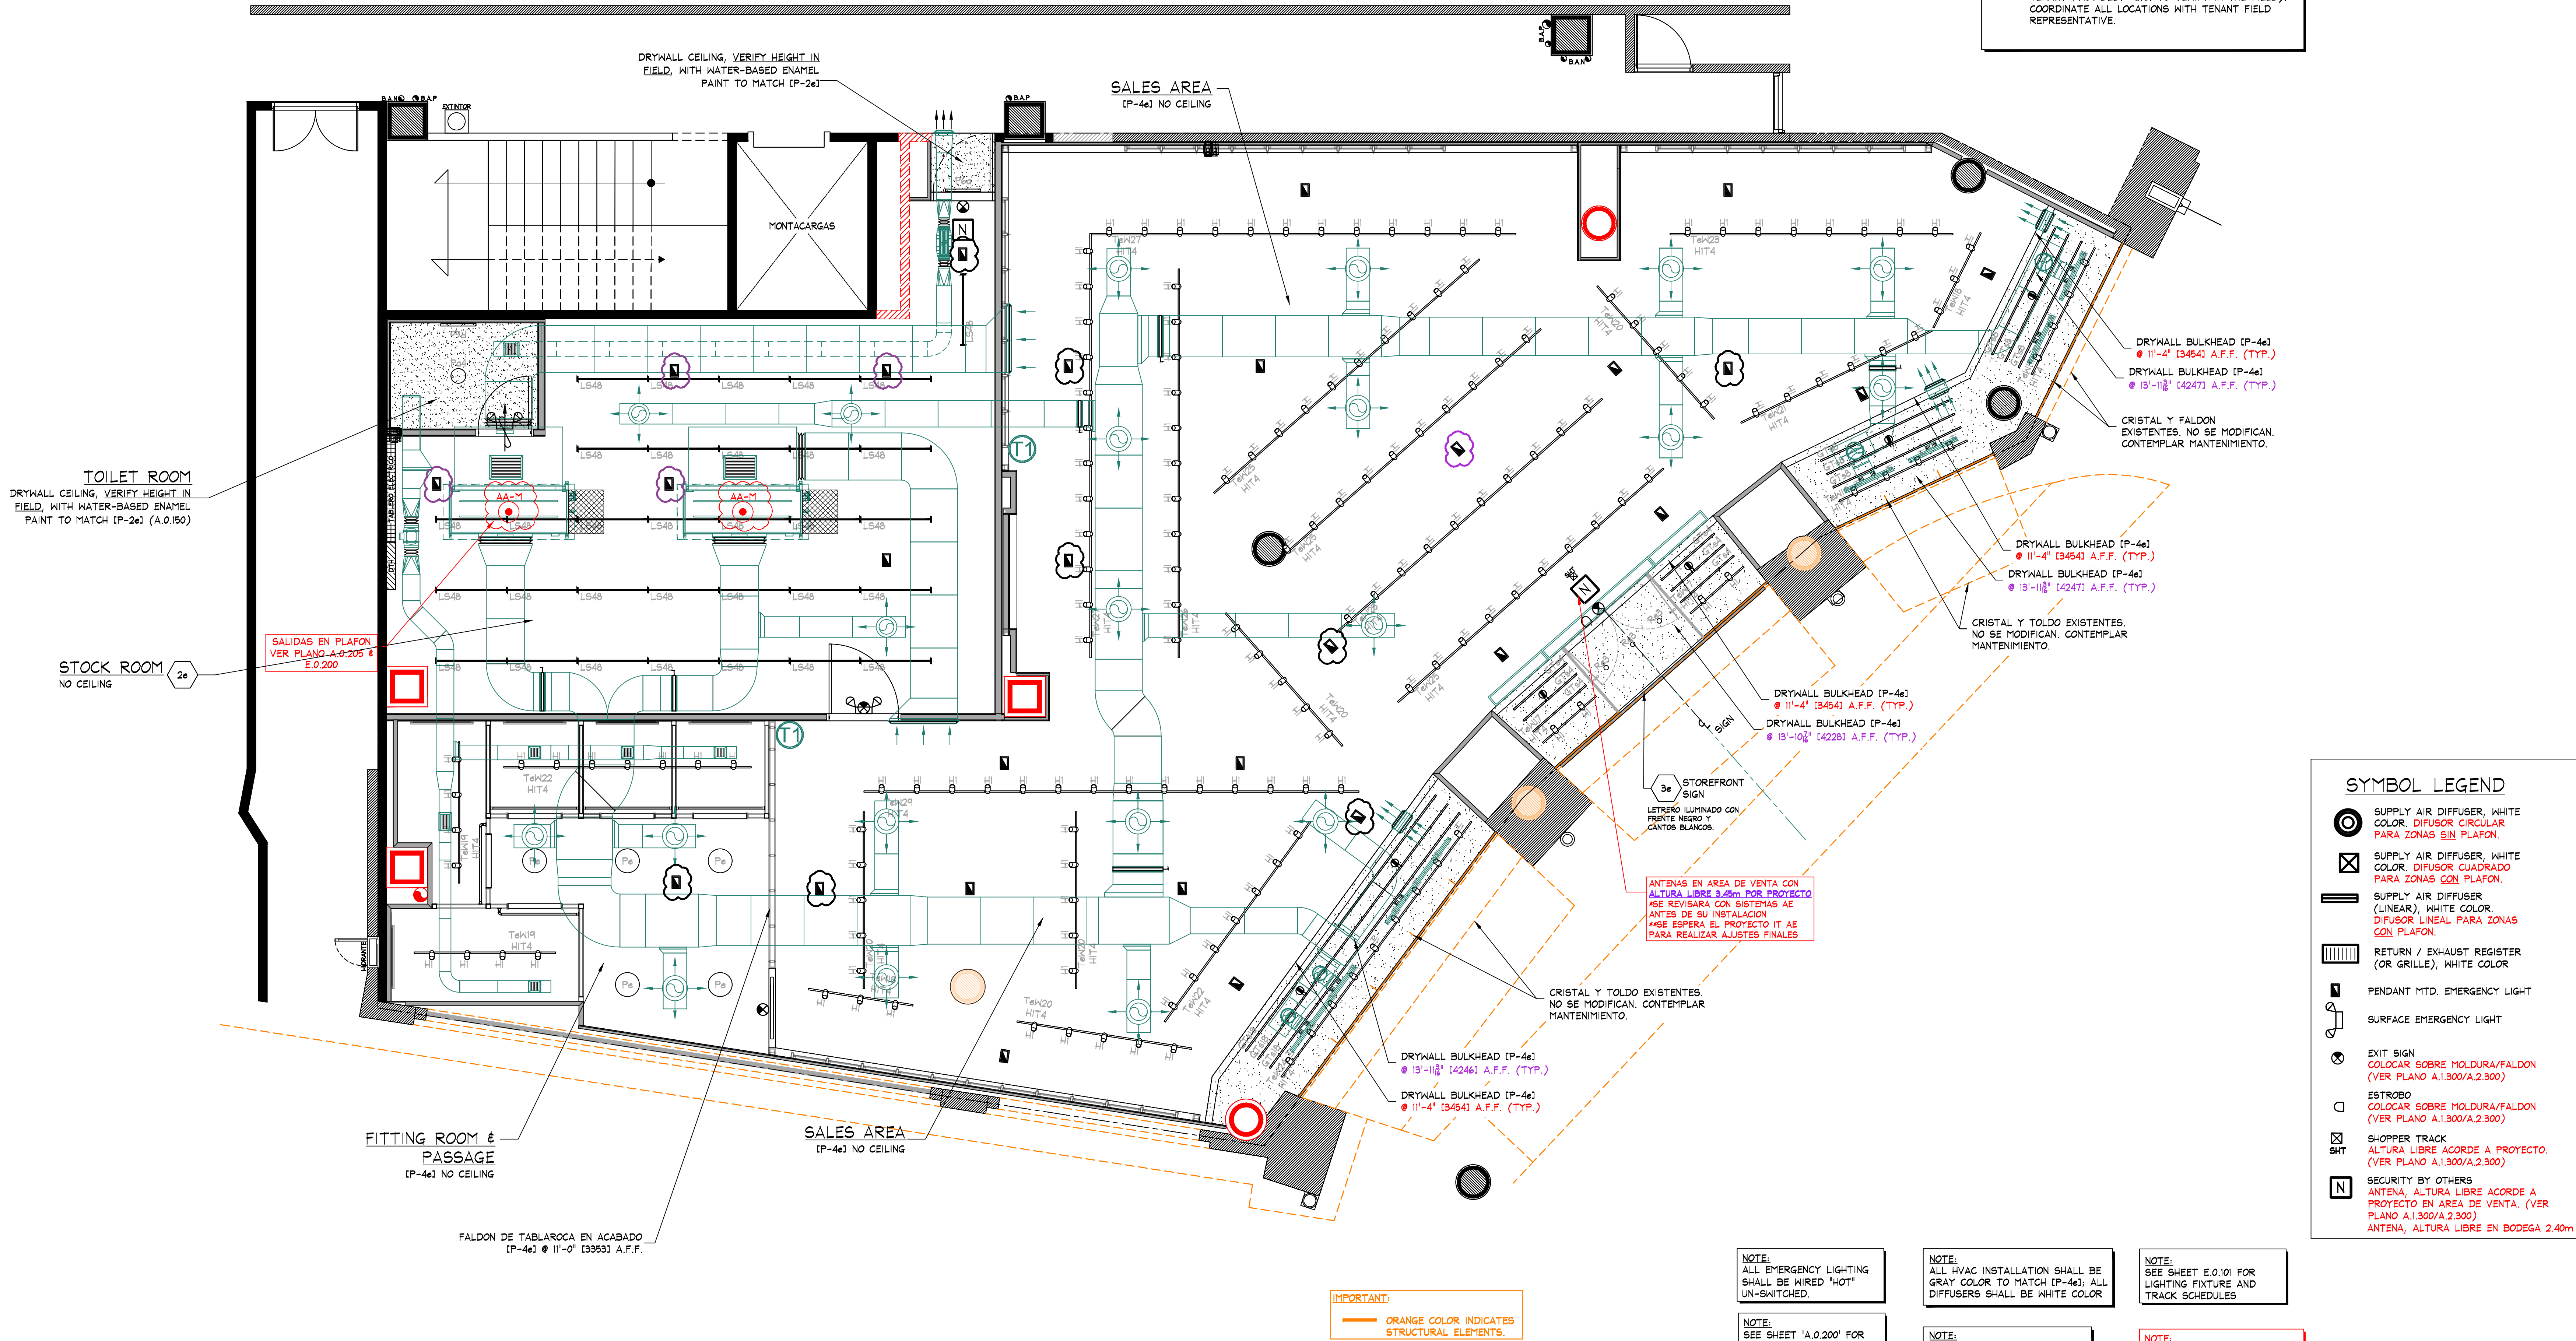

SYMBOL LEGEND

- SUPPLY AIR DIFFUSER, WHITE COLOR, DIFUSOR CIRCULAR PARA ZONAS SIN PLAFON.
- SUPPLY AIR DIFFUSER, WHITE COLOR, DIFUSOR CUADRADO PARA ZONAS CON PLAFON.
- SUPPLY AIR DIFFUSER (LINEAR), WHITE COLOR, DIFUSOR LINEAL PARA ZONAS CON PLAFON.
- RETURN / EXHAUST REGISTER (OR GRILLE), WHITE COLOR.
- PENDANT MTD. EMERGENCY LIGHT.
- SURFACE EMERGENCY LIGHT.
- EXIT SIGN COLOCAR SOBRE MOLDURA/FALDON (VER PLANO A.1.300/A.2.300).
- ESTROBO COLOCAR SOBRE MOLDURA/FALDON (VER PLANO A.1.300/A.2.300).
- SHOPPER TRACK ALTURA LIBRE ACORDE A PROYECTO. (VER PLANO A.1.300/A.2.300).
- SECURITY BY OTHERS ANTENA, ALTURA LIBRE ACORDE A PROYECTO EN AREA DE VENTA. (VER PLANO A.1.300/A.2.300).
- ANTENA, ALTURA LIBRE EN BODEGA 2.40m.

NOTE: ALL EMERGENCY LIGHTING SHALL BE WIRED "HOT" UN-SWITCHED.

NOTE: SEE SHEET 'A.0.200' FOR FIXTURE LOCATING DIMENSIONS.

NOTE: SECURE ALL LIGHTING TRACK TO CEILING WITH TOGGLE BOLTS WHERE OCCURS.

NOTE: SEE SHEET A.0.200 FOR ALL CEILING HEIGHTS.

NOTE: SEE SHEET E.0.400 AND/OR E.0.401 FOR ELECTRICAL INSTALLATION DETAILS.

NOTE: ALL HVAC INSTALLATION SHALL BE GRAY COLOR TO MATCH (P-4a). ALL DIFFUSERS SHALL BE WHITE COLOR.

NOTE: G.C. TO PAINT EVERYTHING ABOVE 11'-4" (P-4a). DO NOT PAINT EQUIPMENT INFORMATION TAGS!!

NOTE: REFER TO SHEET E.0.500 FOR ALL CEILING MOUNTED LOW VOLTAGE DEVICES. REFER TO SHEET E.0.501 FOR INSTALLATION OF LOW VOLTAGE DEVICES.

NOTE: SEE SHEET E.0.101 FOR TRACK SCHEDULES.

NOTE: PRIOR TO START ANY INSTALLATION WORK, G.C. SHALL VERIFY FINAL LOCATION FOR THIS PROJECT (CCTV, SENSORMATIC, ETC.).

NOTE: SE DEBERA REVISAR LA ALTURA TOTAL EXISTENTE EN LOCAL.


NOTE:

- NO WIRING SHALL EXTEND FROM SUPPORT TRACK TO ANY OTHER SUPPORT TRACK, WALL, OR PERIMETER CONSTRUCTION. ALL WIRING RUNS SHALL BE STRAIGHT HORIZONTAL OR VERTICAL, STRAP AND SECURE AS REQUIRED TO MAINTAIN ORGANIZED LOOK.
- ALL WIRING AT PERIMETER WALLS SHALL BE STRAPPED NEATLY HORIZONTAL OR VERTICAL AS REQUIRED.
- ALL VALANCE OR PERIMETER WIRING SHALL BE STRAPPED TIGHTLY TO THE TOP OF VALANCE CASE TO ELIMINATE VIEW FROM SALES FLOOR.
- ALL ELECTRICAL BOXES SHOULD BE HELD TIGHT TO WALLS.

DEVICE COORDINATION REFLECTED CEILING PLAN

SCALE: 1/4" = 1'-0" (1:50)

INDICA AJUSTES EN PLAFON POR DUCTERIA DE A.A.

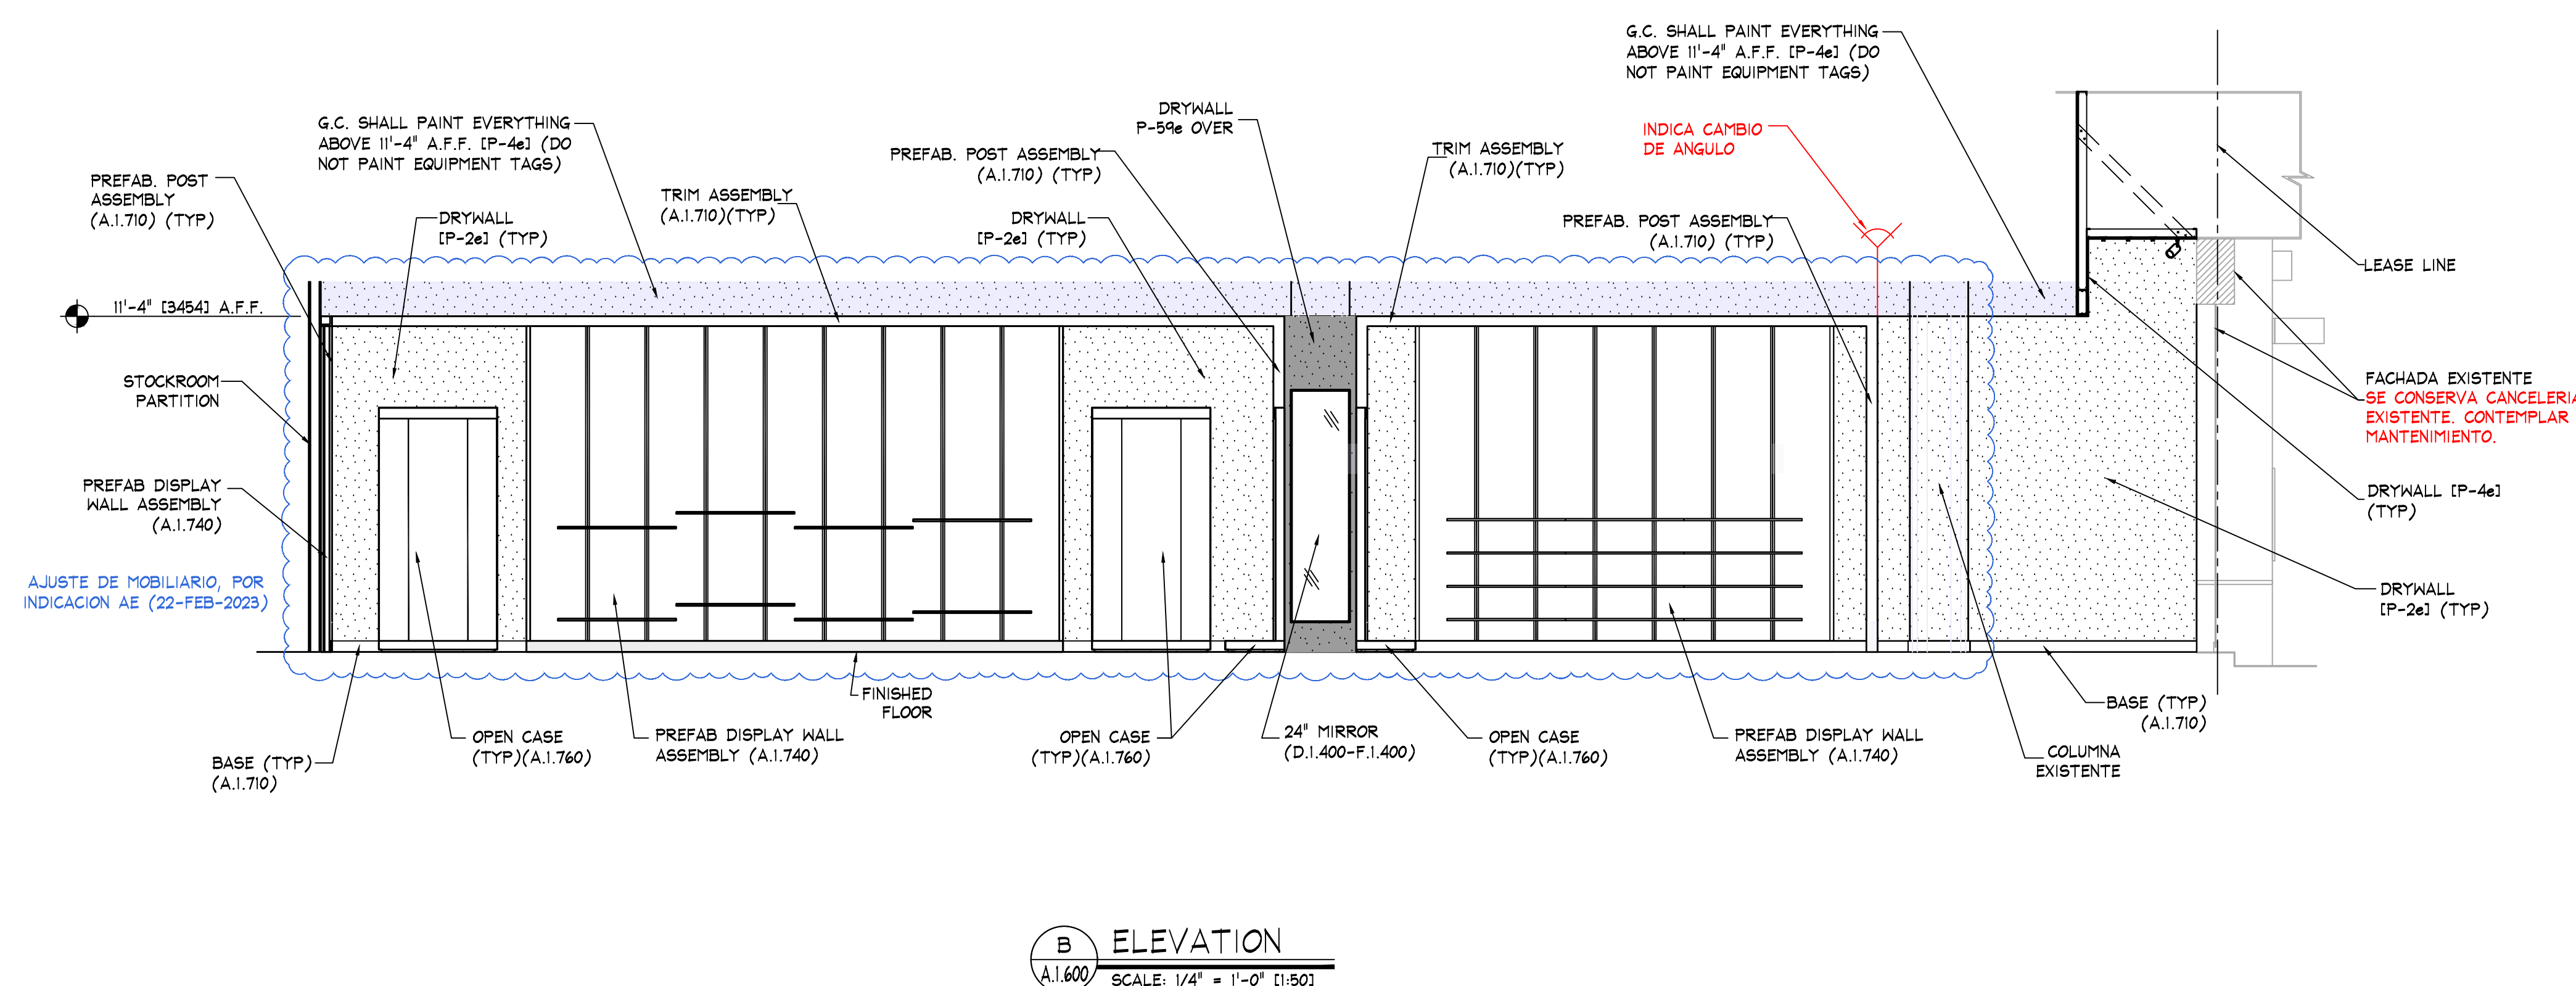




KEY NOTES:

1e SIGN - FURNISHED BY SIGN CONSULTANT
INST. BY G.C. - SEE SHEETS 'A.1.800'

3e VERIFICAR CON AE PREVIO A
FABRICACION TEMPERATURA,
DIMENSION Y TIPOGRAFIA.

NOTE:
PAINTING CONTRACTOR SHALL CAULK ALL
INSIDE WOOD CORNERS AND JOINTS
BETWEEN TRIM & WALL PRIOR TO PAINTING

NOTE:
DETAILS, NOTES, AND/OR SPECIFICATIONS ON
THIS SHEET NOT LISTED ALPHABETICALLY OR
NUMERICALLY HAVE BEEN PURPOSELY OMITTED
AND DO NOT PERTAIN TO THIS PROJECT

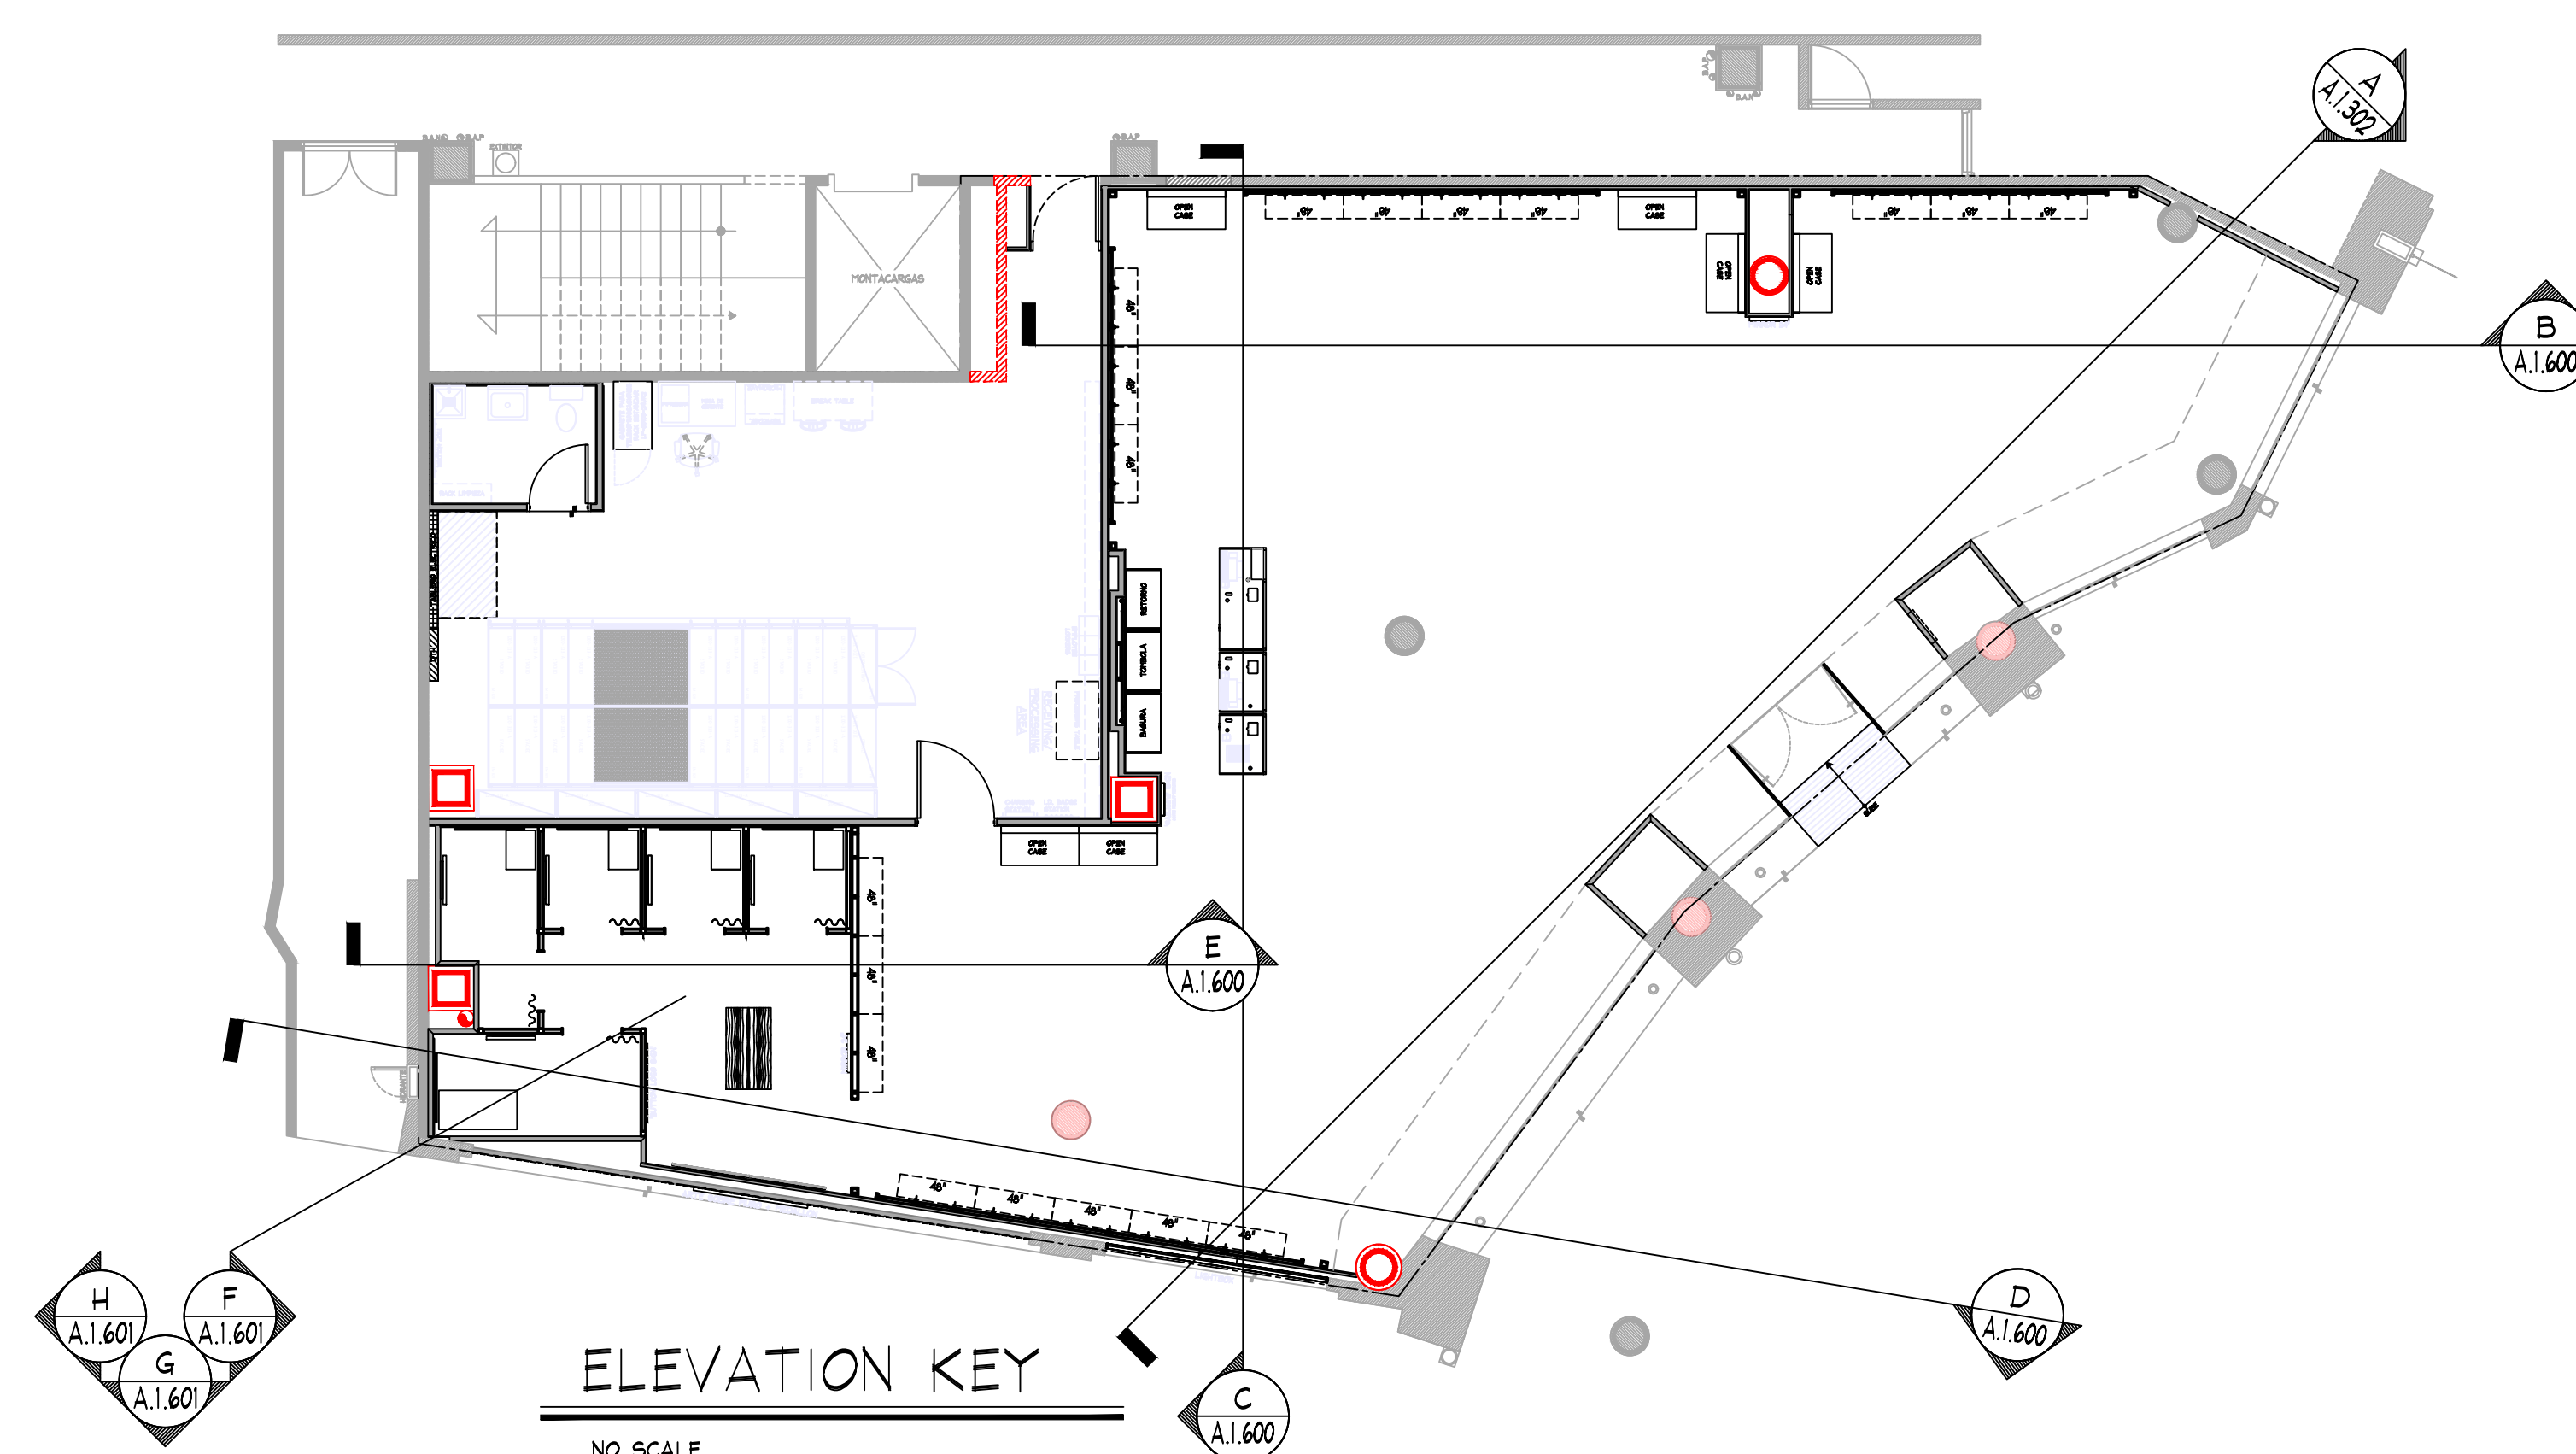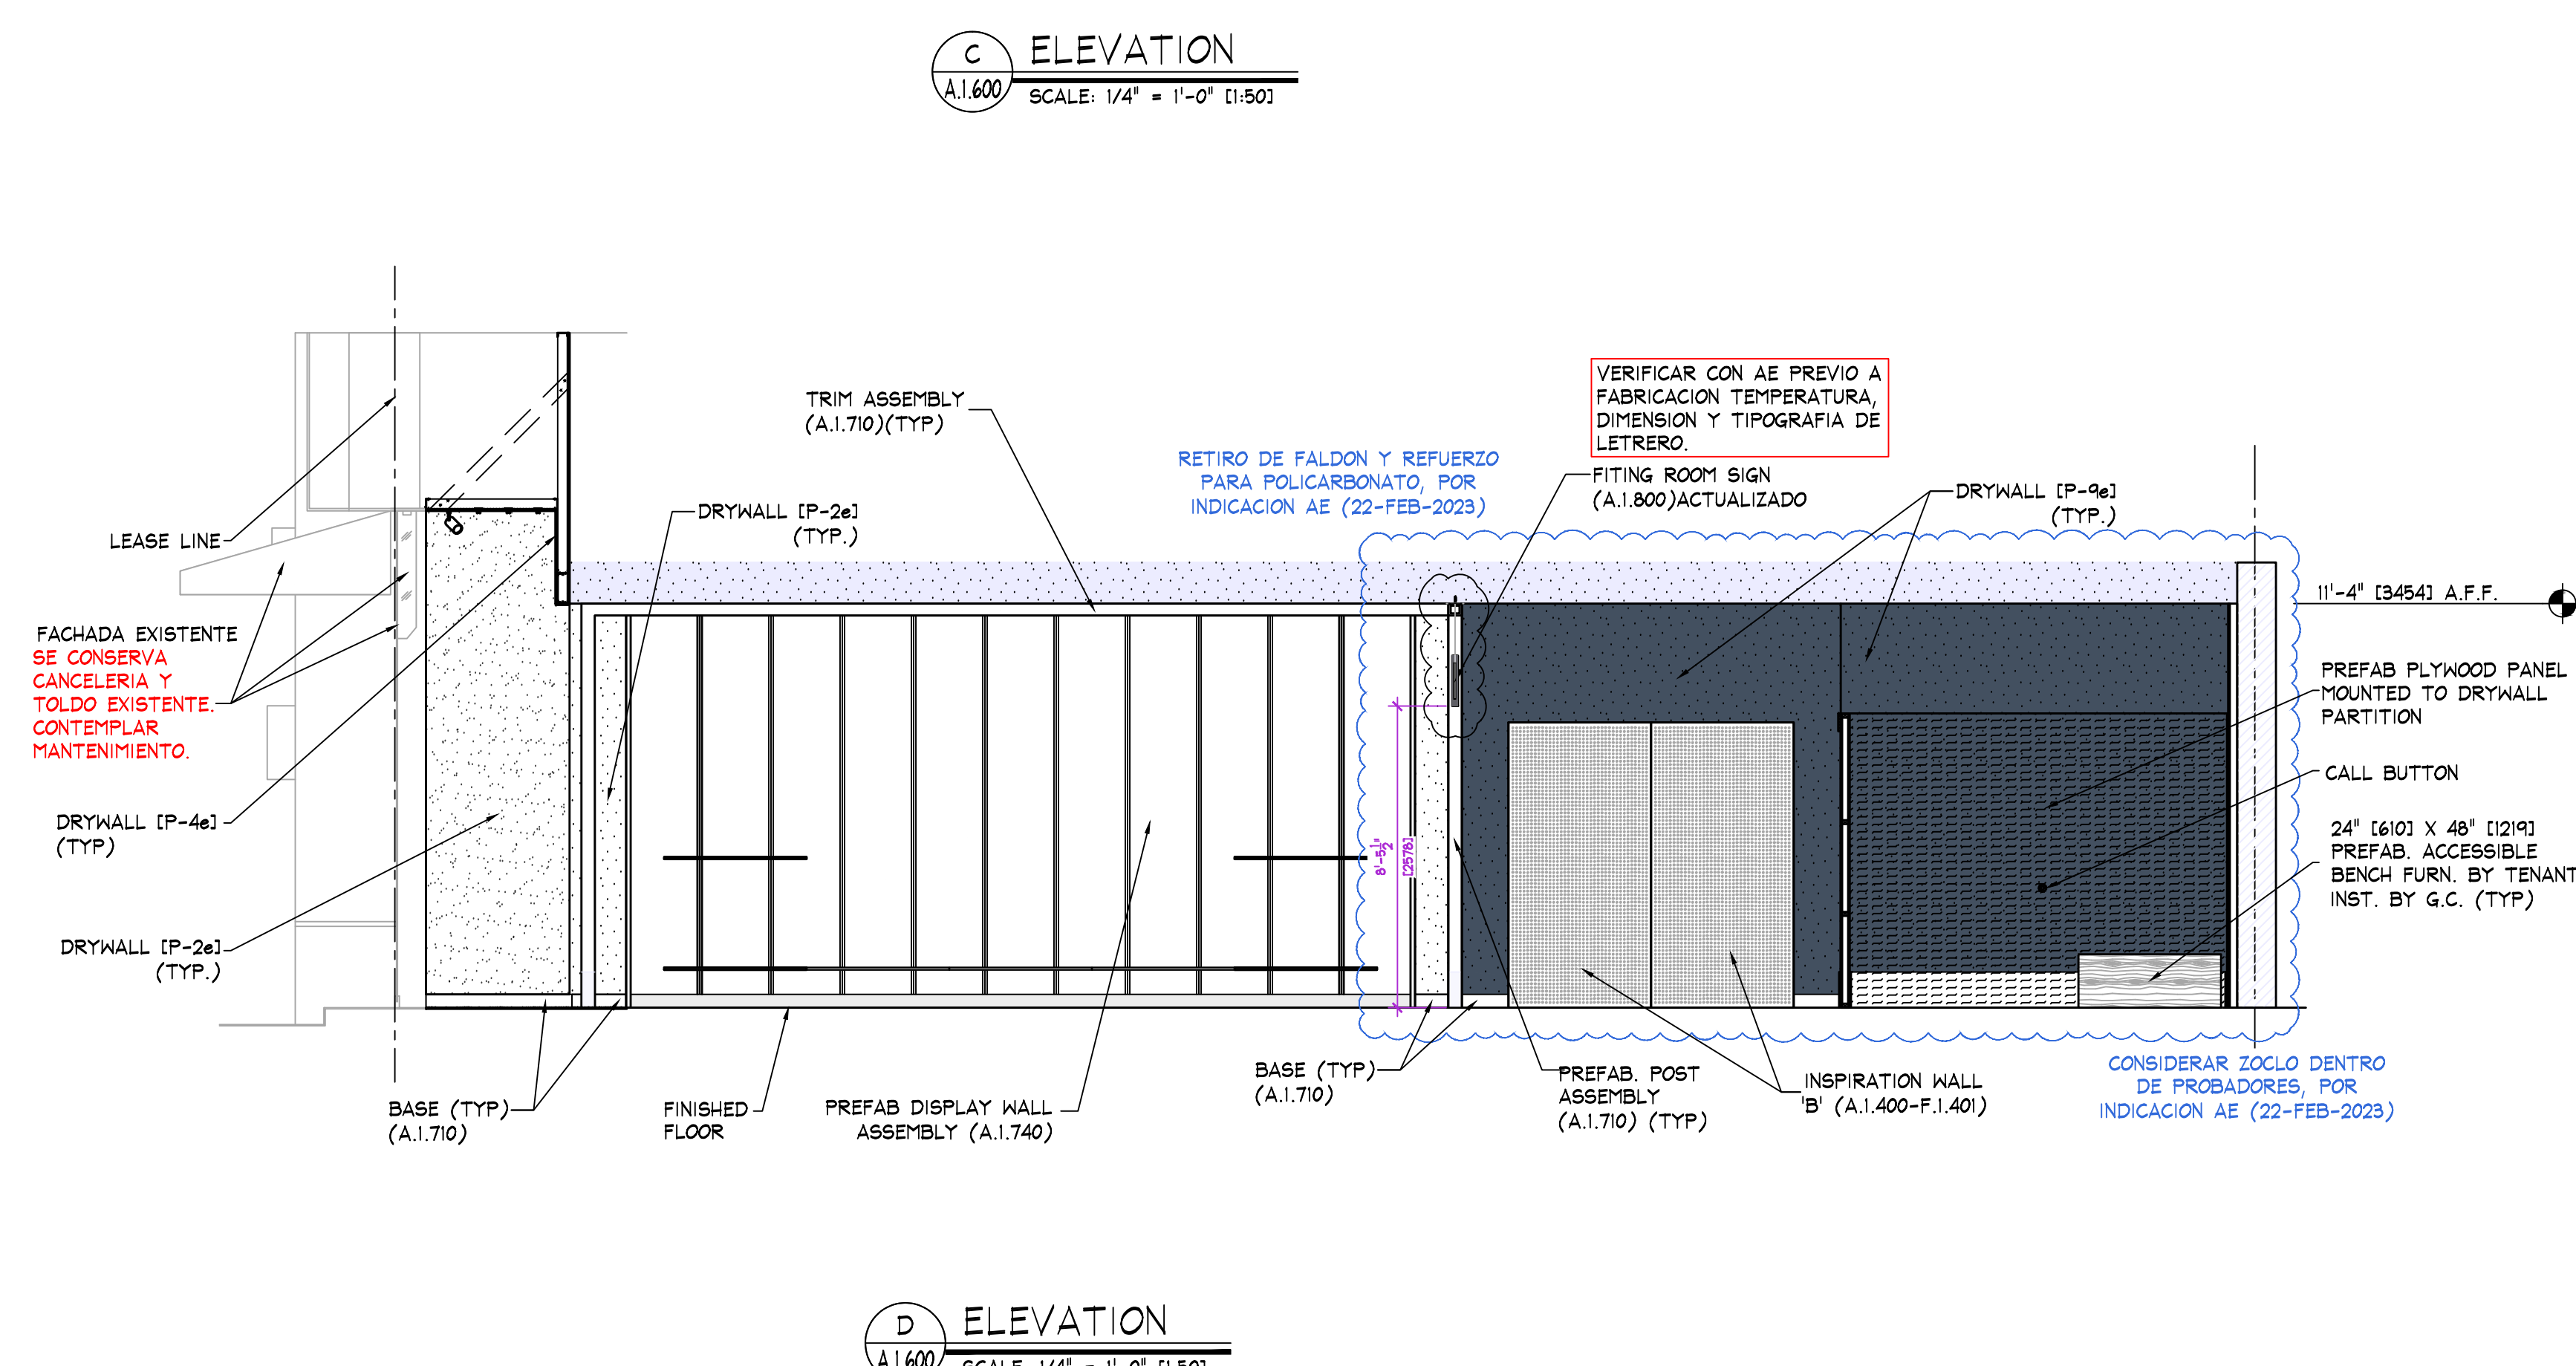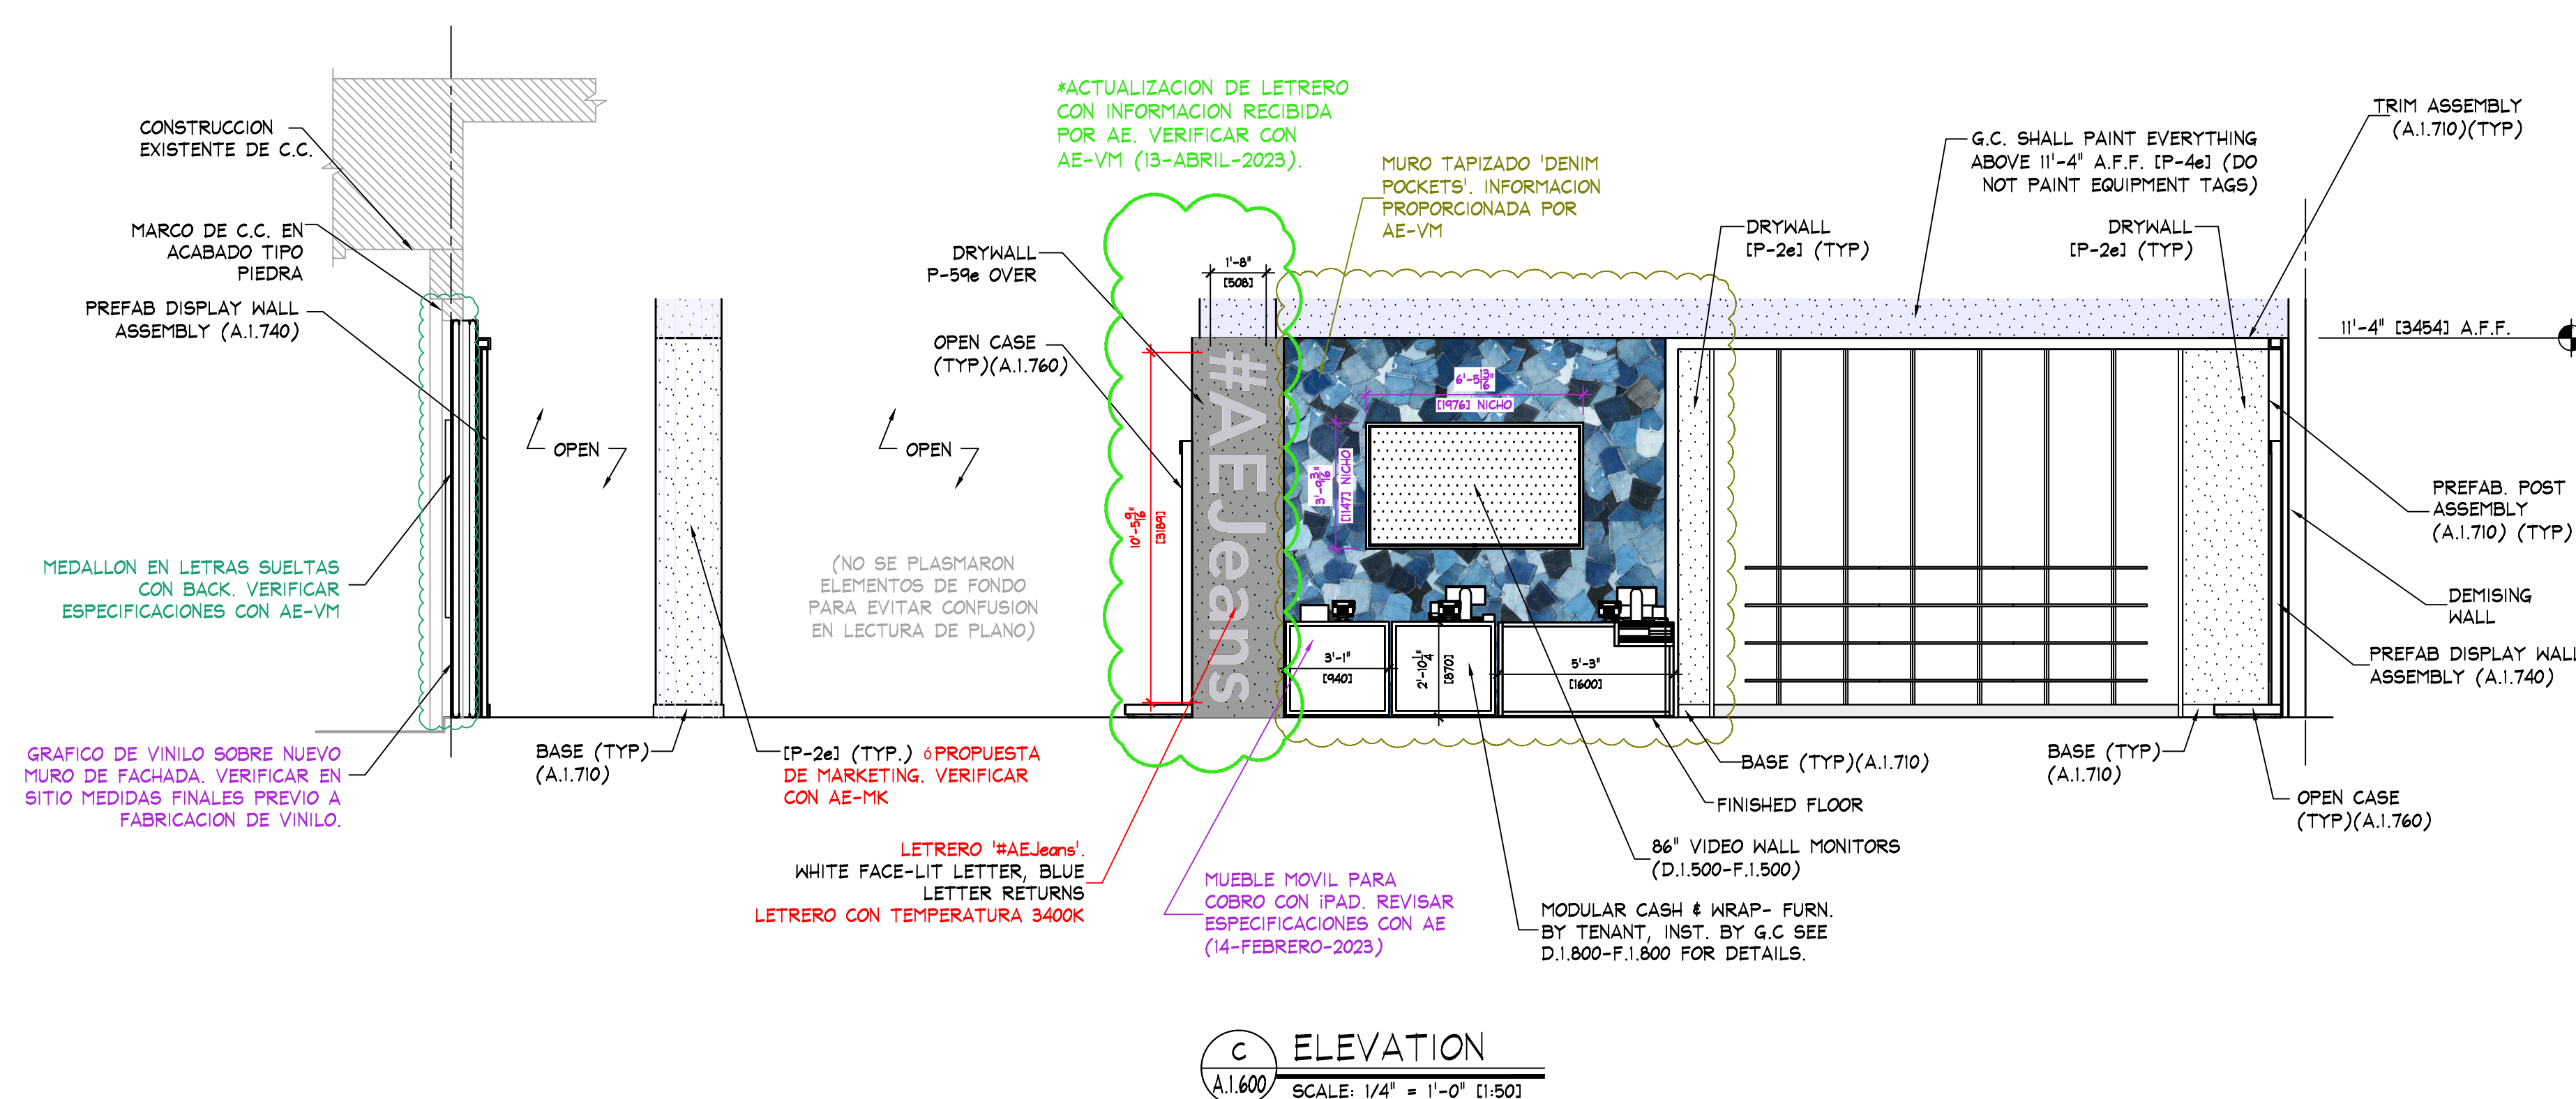

**OFFLINE INTERIOR
ELEVATIONS**

AMERICAN EAGLE OUTFITTERS
C. C. Paseo Altozano
Morelia, Michoacan

Space # PB-07 08

Store No.
9270
Drawn by:
Drawing No.

A.1.600

ULTIMA ACTUALIZACION DE PROYECTO CON MEDIDAS AS BUILT POR AE-CONSTRUCCION + AJUSTES INDICADOS POR AE (22-FEBRERO-2023)
 *CAMBIO DE LETRERO DE MADERA POR ACRILICO TRANSPARENTE, INDICACION POR AE (03-MARZO-2023).
 ULTIMA ACTUALIZACION DE PROYECTO POR INDICACION AE (27-MARZO-2023) // ULTIMA ACTUALIZACION DE PROYECTO CONFORME A INFORMACION AS BUILT (05-ABRIL-2023)



1e
3e

SIGN - FURNISHED BY SIGN CONSULTANT
INST. BY G.C. - SEE SHEETS 'A.1.800'

VERIFICAR CON AE PREVIO A
FABRICACION TEMPERATURA,
DIMENSION Y TIPOGRAFIA.

NOTE:
PAINTING CONTRACTOR SHALL CAULK ALL
INSIDE WOOD CORNERS AND JOINTS
BETWEEN TRIM & WALL PRIOR TO PAINTING

NOTE:
DETAILS, NOTES, AND/OR SPECIFICATIONS ON
THIS SHEET NOT LISTED ALPHABETICALLY OR
NUMERICALLY HAVE BEEN PURPOSELY OMITTED
AND DO NOT PERTAIN TO THIS PROJECT.

