


SCALE: 1/4" = 1'-0" [1:50]

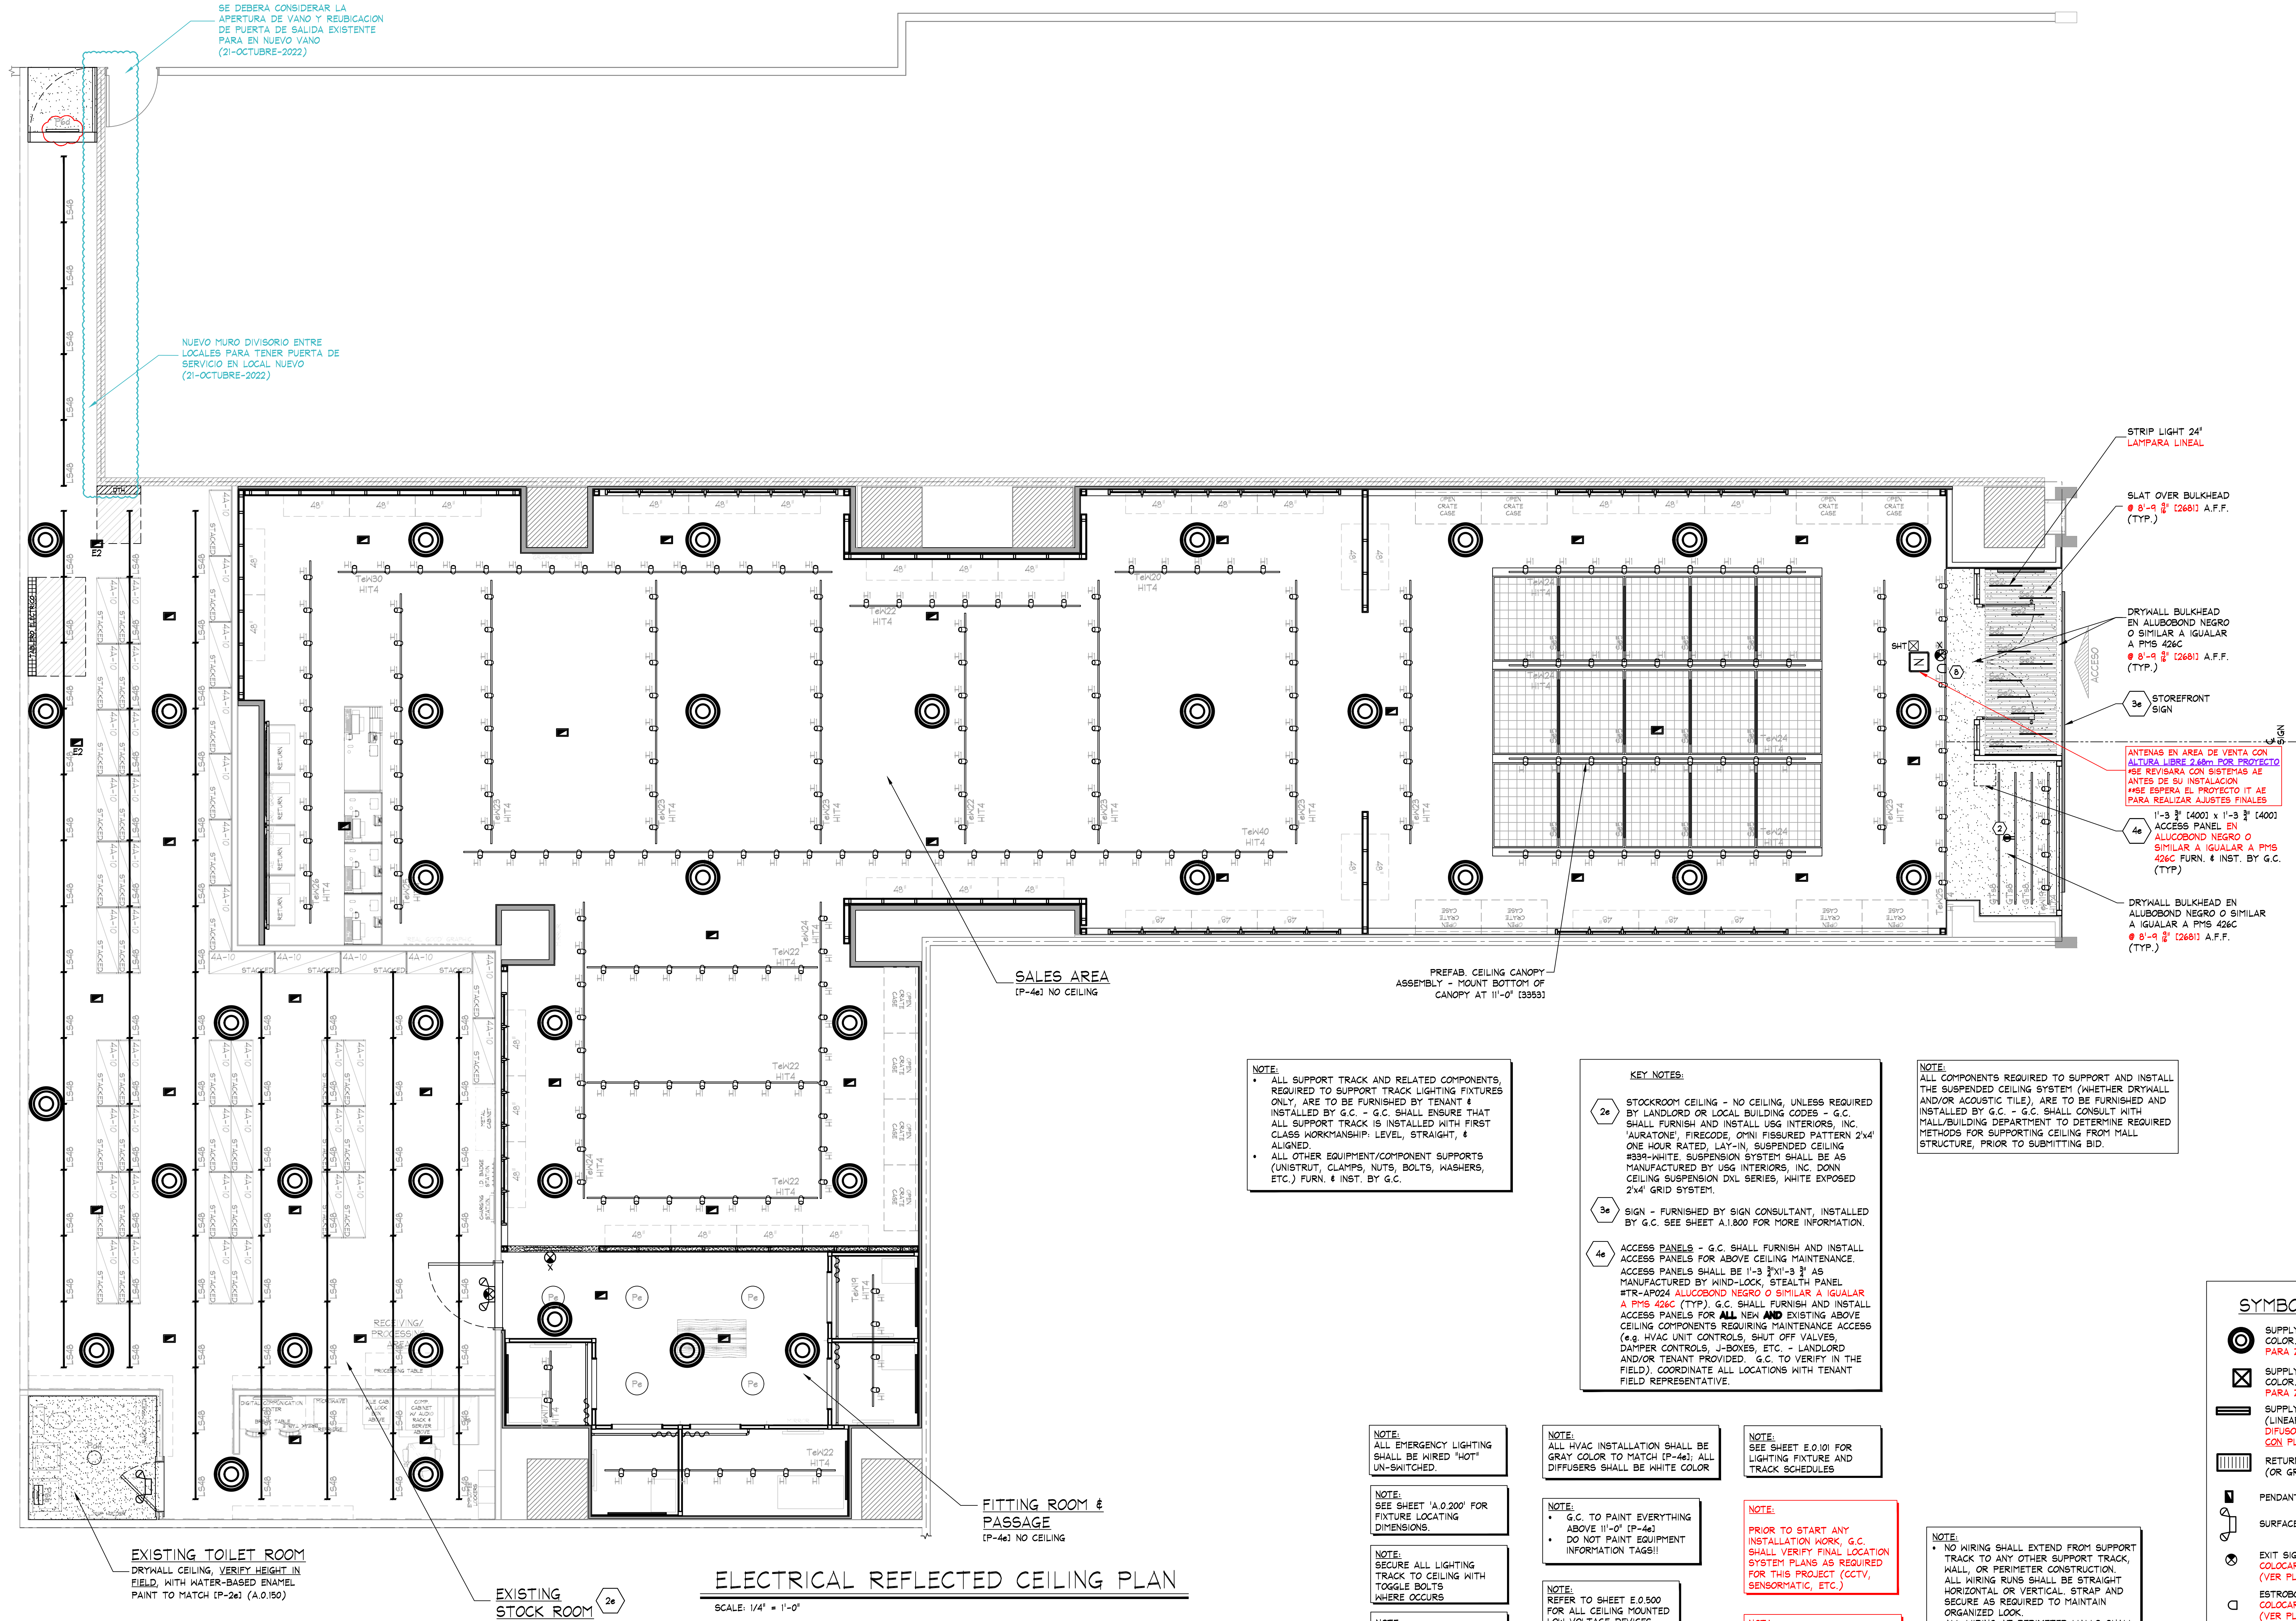

SE DEBERA CONSIDERAR LA APERTURA DE VANO Y REUBICACION DE PUERTA DE SALIDA EXISTENTE PARA EN NUEVO VANO (21-OCTUBRE-2022)

NUEVO MURO DIVISORIO ENTRE LOCALES PARA TENER PUERTA DE SERVICIO EN LOCAL NUEVO (21-OCTUBRE-2022)

EXISTING TOILET ROOM
DRYWALL CEILING, VERIFY HEIGHT IN FIELD, WITH WATER-BASED ENAMEL PAINT TO MATCH (P-2e) (A.0.150)

EXISTING STOCK ROOM
NO CEILING

SALES AREA
(P-4e) NO CEILING

FITTING ROOM & PASSAGE
(P-4e) NO CEILING

NOTE:
ALL SUPPORT TRACK AND RELATED COMPONENTS, REQUIRED TO SUPPORT TRACK LIGHTING FIXTURES ONLY, ARE TO BE FURNISHED BY TENANT & INSTALLED BY G.C. - G.C. SHALL ENSURE THAT ALL SUPPORT TRACK IS INSTALLED WITH FIRST CLASS WORKMANSHIP: LEVEL, STRAIGHT, & ALIGNED.
ALL OTHER EQUIPMENT/COMPONENT SUPPORTS (UNISTRUT, CLAMPS, NUTS, BOLTS, WASHERS, ETC.) FURN. & INST. BY G.C.

NOTE:
ALL EMERGENCY LIGHTING SHALL BE WIRED "HOT" UN-SWITCHED.

NOTE:
SEE SHEET 'A.0.200' FOR FIXTURE LOCATING DIMENSIONS.

NOTE:
SECURE ALL LIGHTING TRACK TO CEILING WITH TOGGLE BOLTS WHERE OCCURS

NOTE:
SEE SHEET A.0.200 FOR ALL CEILING HEIGHTS.

NOTE:
SEE SHEET E.0.400 AND/OR E.0.401 FOR ELECTRICAL INSTALLATION DETAILS.

NOTE:
ALL HVAC INSTALLATION SHALL BE GRAY COLOR TO MATCH (P-4e); ALL DIFFUSERS SHALL BE WHITE COLOR

NOTE:
G.C. TO PAINT EVERYTHING ABOVE (P-4e)
DO NOT PAINT EQUIPMENT INFORMATION TAGS!!

NOTE:
REFER TO SHEET E.0.500 FOR ALL CEILING MOUNTED LOW VOLTAGE DEVICES
REFER TO SHEET E.0.501 FOR INSTALLATION OF LOW VOLTAGE DEVICES.

NOTE:
PRIOR TO START ANY INSTALLATION WORK, G.C. SHALL VERIFY FINAL LOCATION SYSTEM PLANS AS REQUIRED FOR THIS PROJECT (CCTV, SENSOR/ATC, ETC.)

NOTE:
SE DEBERA REVISAR LA ALTURA TOTAL EXISTENTE EN LOCAL

NOTE:
NO WIRING SHALL EXTEND FROM SUPPORT TRACK TO ANY OTHER SUPPORT TRACK, WALL, OR PERIMETER CONSTRUCTION. ALL WIRING RUNS SHALL BE STRAIGHT HORIZONTAL OR VERTICAL. STRAP AND SECURE AS REQUIRED TO MAINTAIN ORGANIZED LOOK.
ALL WIRING AT PERIMETER WALLS SHALL BE STRAPPED TIGHTLY TO THE TOP OF VALANCE CASE TO ELIMINATE VIEW FROM SALES FLOOR.
ALL ELECTRICAL BOXES SHOULD BE HELD TIGHT TO WALLS.

KEY NOTES:
2e STOCKROOM CEILING - NO CEILING, UNLESS REQUIRED BY LANDLORD OR LOCAL BUILDING CODES - G.C. SHALL FURNISH AND INSTALL USG INTERIORS, INC. 'AURATONE', FIRECODE, OMNI FIGURED PATTERN 2'x4' ONE HOUR RATED, LAY-IN, SUSPENDED CEILING #394-WHITE. SUSPENSION SYSTEM SHALL BE AS MANUFACTURED BY USG INTERIORS, INC. DOWN CEILING SUSPENSION DXL SERIES, WHITE EXPOSED 2'x4' GRID SYSTEM.
3e SIGN - FURNISHED BY SIGN CONSULTANT, INSTALLED BY G.C. SEE SHEET A.1.800 FOR MORE INFORMATION.
4e ACCESS PANELS - G.C. SHALL FURNISH AND INSTALL ACCESS PANELS FOR ABOVE CEILING MAINTENANCE. ACCESS PANELS SHALL BE 1'-3 3/4" x 1'-3 3/4" AS MANUFACTURED BY WIND-LOCK, STEALTH PANEL #TR-AP024 ALUCOBOND NEGRO O SIMILAR A IGUALAR A PMS 426C (TYP). G.C. SHALL FURNISH AND INSTALL ACCESS PANELS FOR ALL NEW AND EXISTING ABOVE CEILING COMPONENTS REQUIRING MAINTENANCE ACCESS (e.g. HVAC UNIT CONTROLS, SHUT OFF VALVES, DAMPER CONTROLS, J-BOXES, ETC. - LANDLORD AND/OR TENANT PROVIDED. G.C. TO VERIFY IN THE FIELD). COORDINATE ALL LOCATIONS WITH TENANT FIELD REPRESENTATIVE.

STRIP LIGHT 24' LAMPARA LINEAL
SLAT OVER BULKHEAD 8'-9 3/4" (2681) A.F.F. (TYP.)
DRYWALL BULKHEAD EN ALUCOBOND NEGRO O SIMILAR A IGUALAR A PMS 426C 8'-9 3/4" (2681) A.F.F. (TYP.)
STOREFRONT SIGN
ANTENAS EN AREA DE VENTA CON ALTURA LIBRE 2.40m POR PROYECTO #SE REVISARA CON SISTEMAS AE ANTES DE SU INSTALACION #SE ESPERA EL PROYECTO IT AE PARA REALIZAR AJUSTES FINALES
1'-3 3/4" [4001] x 1'-3 3/4" [4001] ACCESS PANEL EN ALUCOBOND NEGRO O SIMILAR A IGUALAR A PMS 426C FURN. & INST. BY G.C. (TYP.)
DRYWALL BULKHEAD EN ALUCOBOND NEGRO O SIMILAR A IGUALAR A PMS 426C 8'-9 3/4" (2681) A.F.F. (TYP.)

SYMBOL LEGEND
SUPPLY AIR DIFFUSER, WHITE COLOR. DIFUSOR CIRCULAR PARA ZONAS SIN PLAFON.
SUPPLY AIR DIFFUSER, WHITE COLOR. DIFUSOR CUADRADO PARA ZONAS CON PLAFON.
SUPPLY AIR DIFFUSER (LINEAR), WHITE COLOR. DIFUSOR LINEAL PARA ZONAS CON PLAFON.
RETURN / EXHAUST REGISTER (OR GRILLE), WHITE COLOR
PENDANT MTD. EMERGENCY LIGHT
SURFACE EMERGENCY LIGHT
EXIT SIGN COLOCAR SOBRE MOLDURA/FALDON (VER PLANO A.1.300/A.2.300)
ESTROBO COLOCAR SOBRE MOLDURA/FALDON (VER PLANO A.1.300/A.2.300)
SHOPPER TRACK ALTURA LIBRE ACORDE A PROYECTO. (VER PLANO A.1.300/A.2.300)
SECURITY BY OTHERS ANTENA, ALTURA LIBRE ACORDE A PROYECTO EN AREA DE VENTA. (VER PLANO A.1.300/A.2.300) ANTENA, ALTURA LIBRE EN BODEGA 2.40m

SCALE: 1/4" = 1'-0"

PROJECTO AJUSTADO CON RETIRO DE ESCLUSA (21-SEP-2022), ACTUALIZACION CON LEVANTAMIENTO (26-SEP-2022), Y REDLINES RECIBIDOS POR AE U.S.A. (09-NOV-2022)

AMERICAN EAGLE

AMERICAN EAGLE OUTFITTERS, INC.
777 Walnut Street
Pittsburgh, PA 15203
(412) 432-3300

DEVICE COORDINATION
CEILING PLAN

AMERICAN EAGLE OUTFITTERS
C. C. Antea Queretaro
Queretaro, Queretaro




Store No.

9206

Drawn by:

Drawn No.

A.0.205

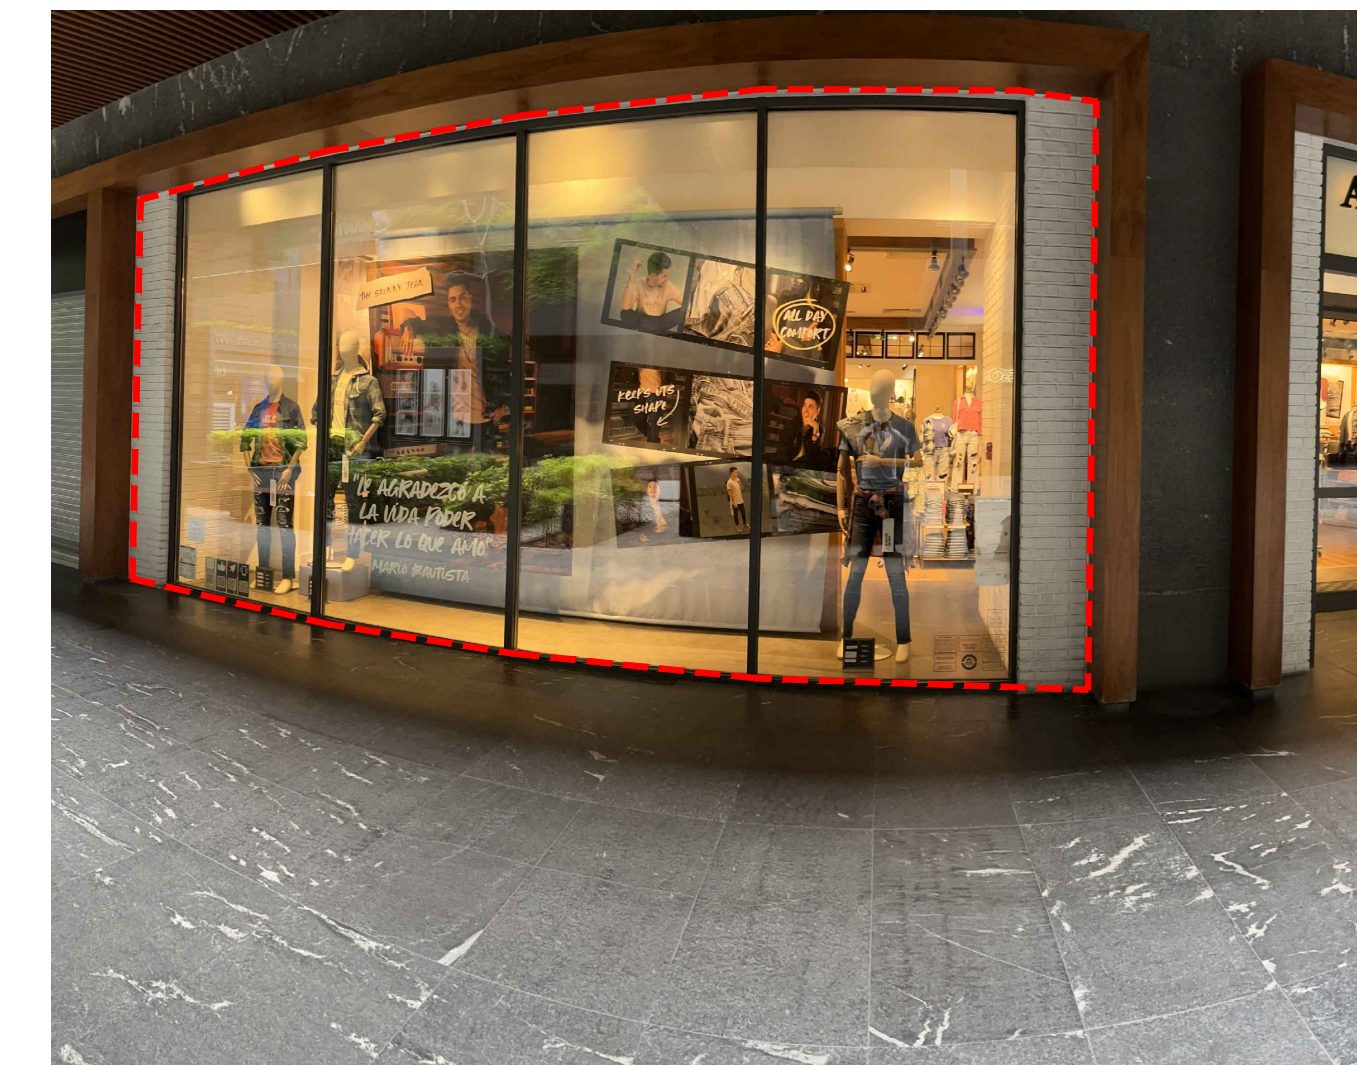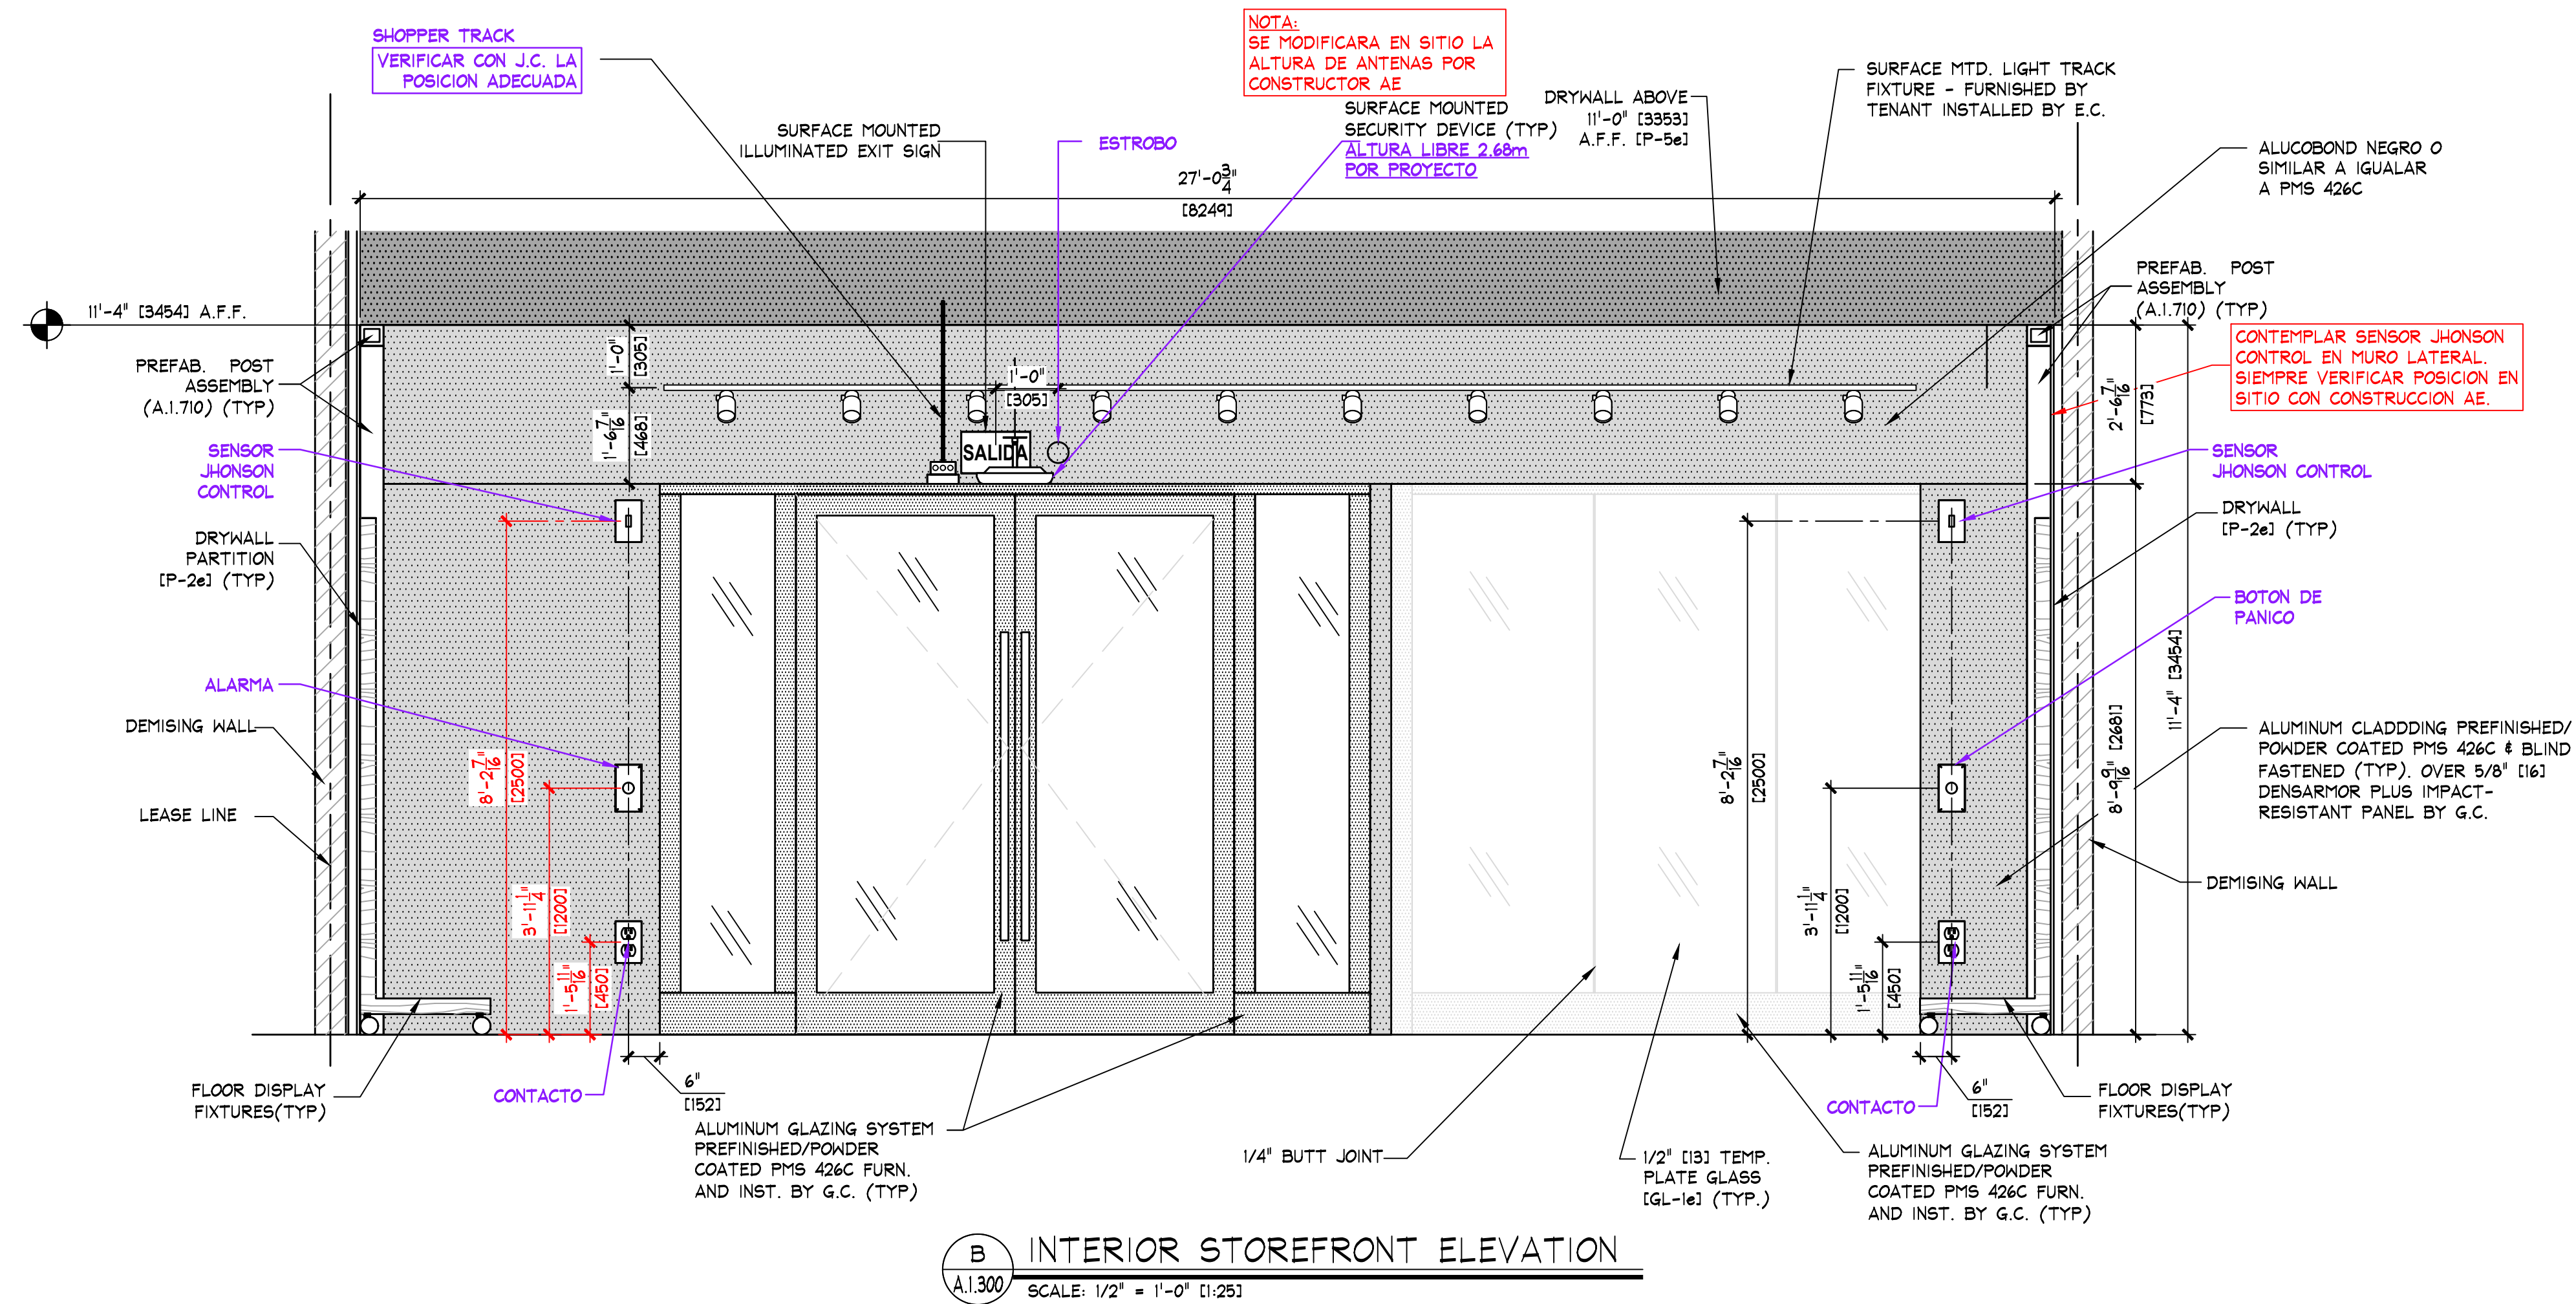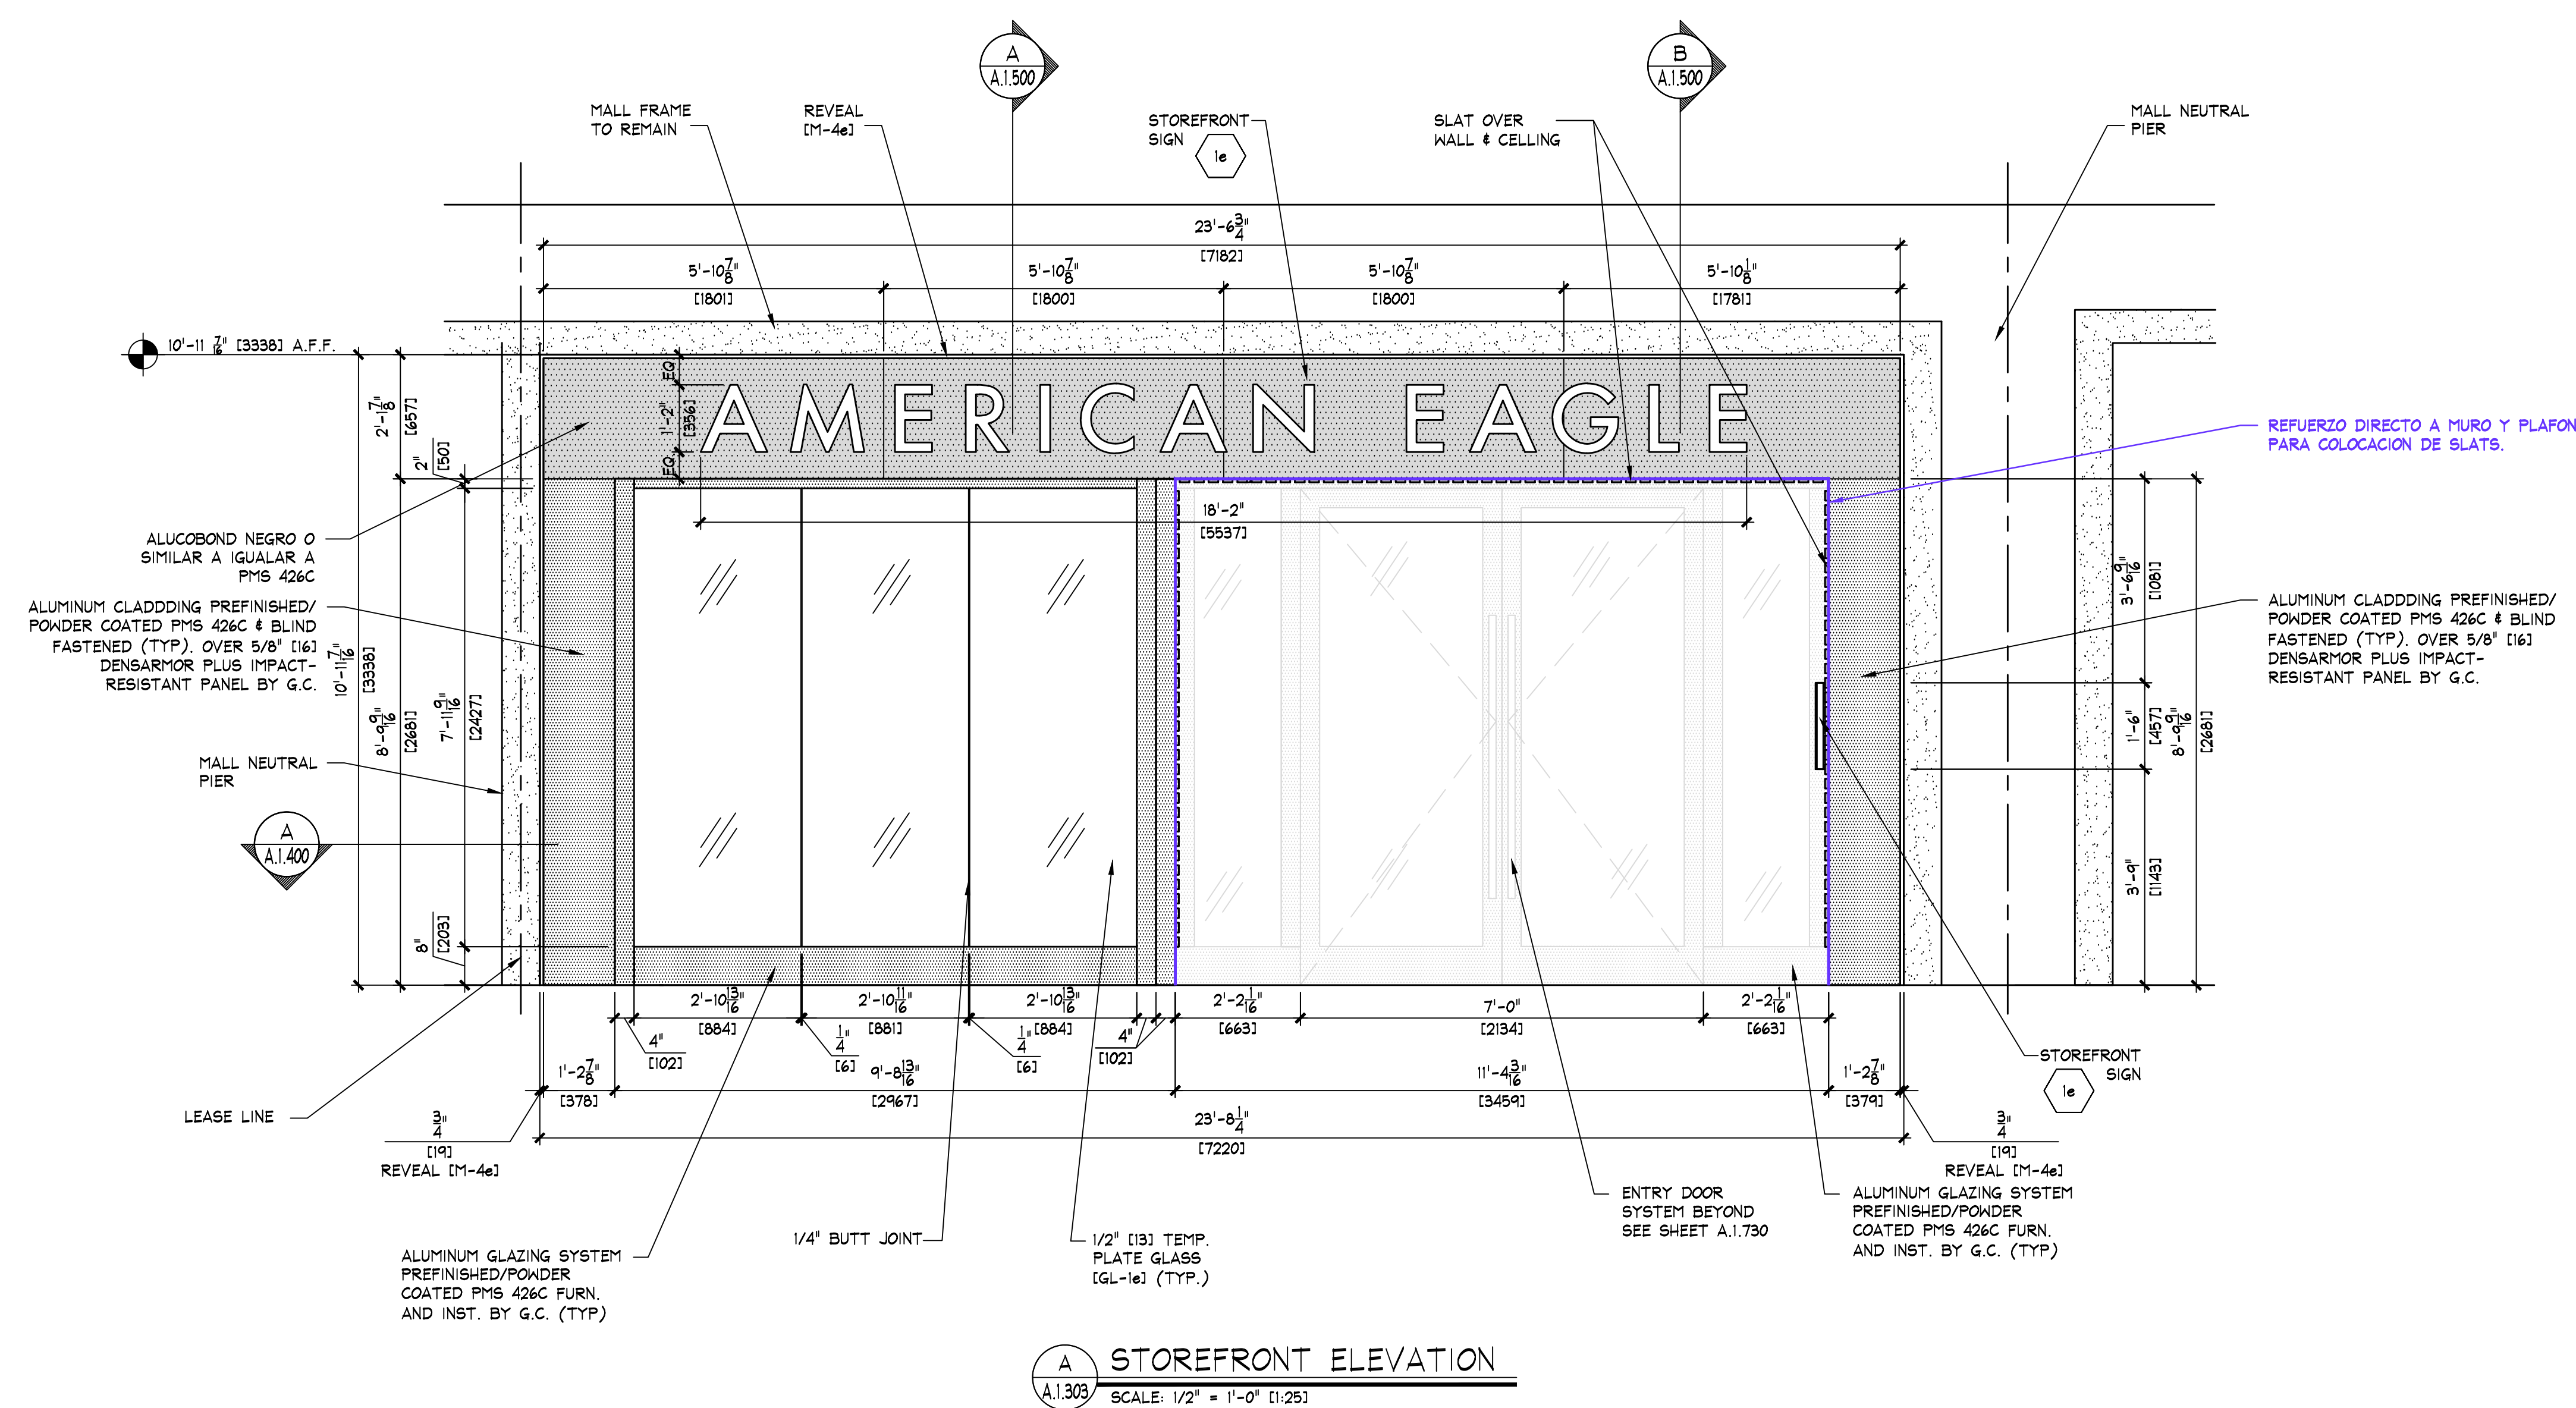

ESTADO ACTUAL DE TIENDA

KEY NOTES:

1a SIGN - FURNISHED BY SIGN CONSULTANT, INSTALLED BY G.C. - SEE SHEET A.1.800 FOR MORE INFORMATION.

NOTE:
PAINTING CONTRACTOR SHALL CAULK ALL INSIDE WOOD CORNERS AND JOINTS BETWEEN TRIM AND WALL PRIOR TO PAINTING.

NOTA:
DIMENSIONES DE LETRERO DE FACHADA SERA ACORDE A LINEAMIENTOS DE MANUAL DE PLAZA SEGUN SE INDIQUE. SIEMPRE VERIFICAR CON AE PREVIO A FABRICACION.


IMPORTANTES:
SIEMPRE CONSIDERAR REGISTRO EN FALDON DE ACCESO PARA LETRERO DE FACHADA DE 400mmx400mm SIEMPRE VERIFICAR EN OBRA


IMPORTANTES:
AREA DE APARADOR SIEMPRE LLEVARA 3 LINEAS DE RIEL PARA GRAFICO.

IMPORTANTES:


- FACHADA PENDIENTE DE REVISION CON C.C. NO SE CUENTA CON INDICACIONES DE MANUAL DE ADAPTACIONES.
- VERIFICAR DISENO DE FACHADA CON MANUAL DE C.C.
- VERIFICAR EN SITIO MEDIDAS PREVIO A TRABAJOS DE FACHADA. ASI COMO APROBACION POR PARTE DE AE Y C.C.

ACTUALIZACION CON LEVANTAMIENTO (28-SEP-2022), Y REDLINES RECIBIDOS POR AE U.S.A. (11-NOV-2022)

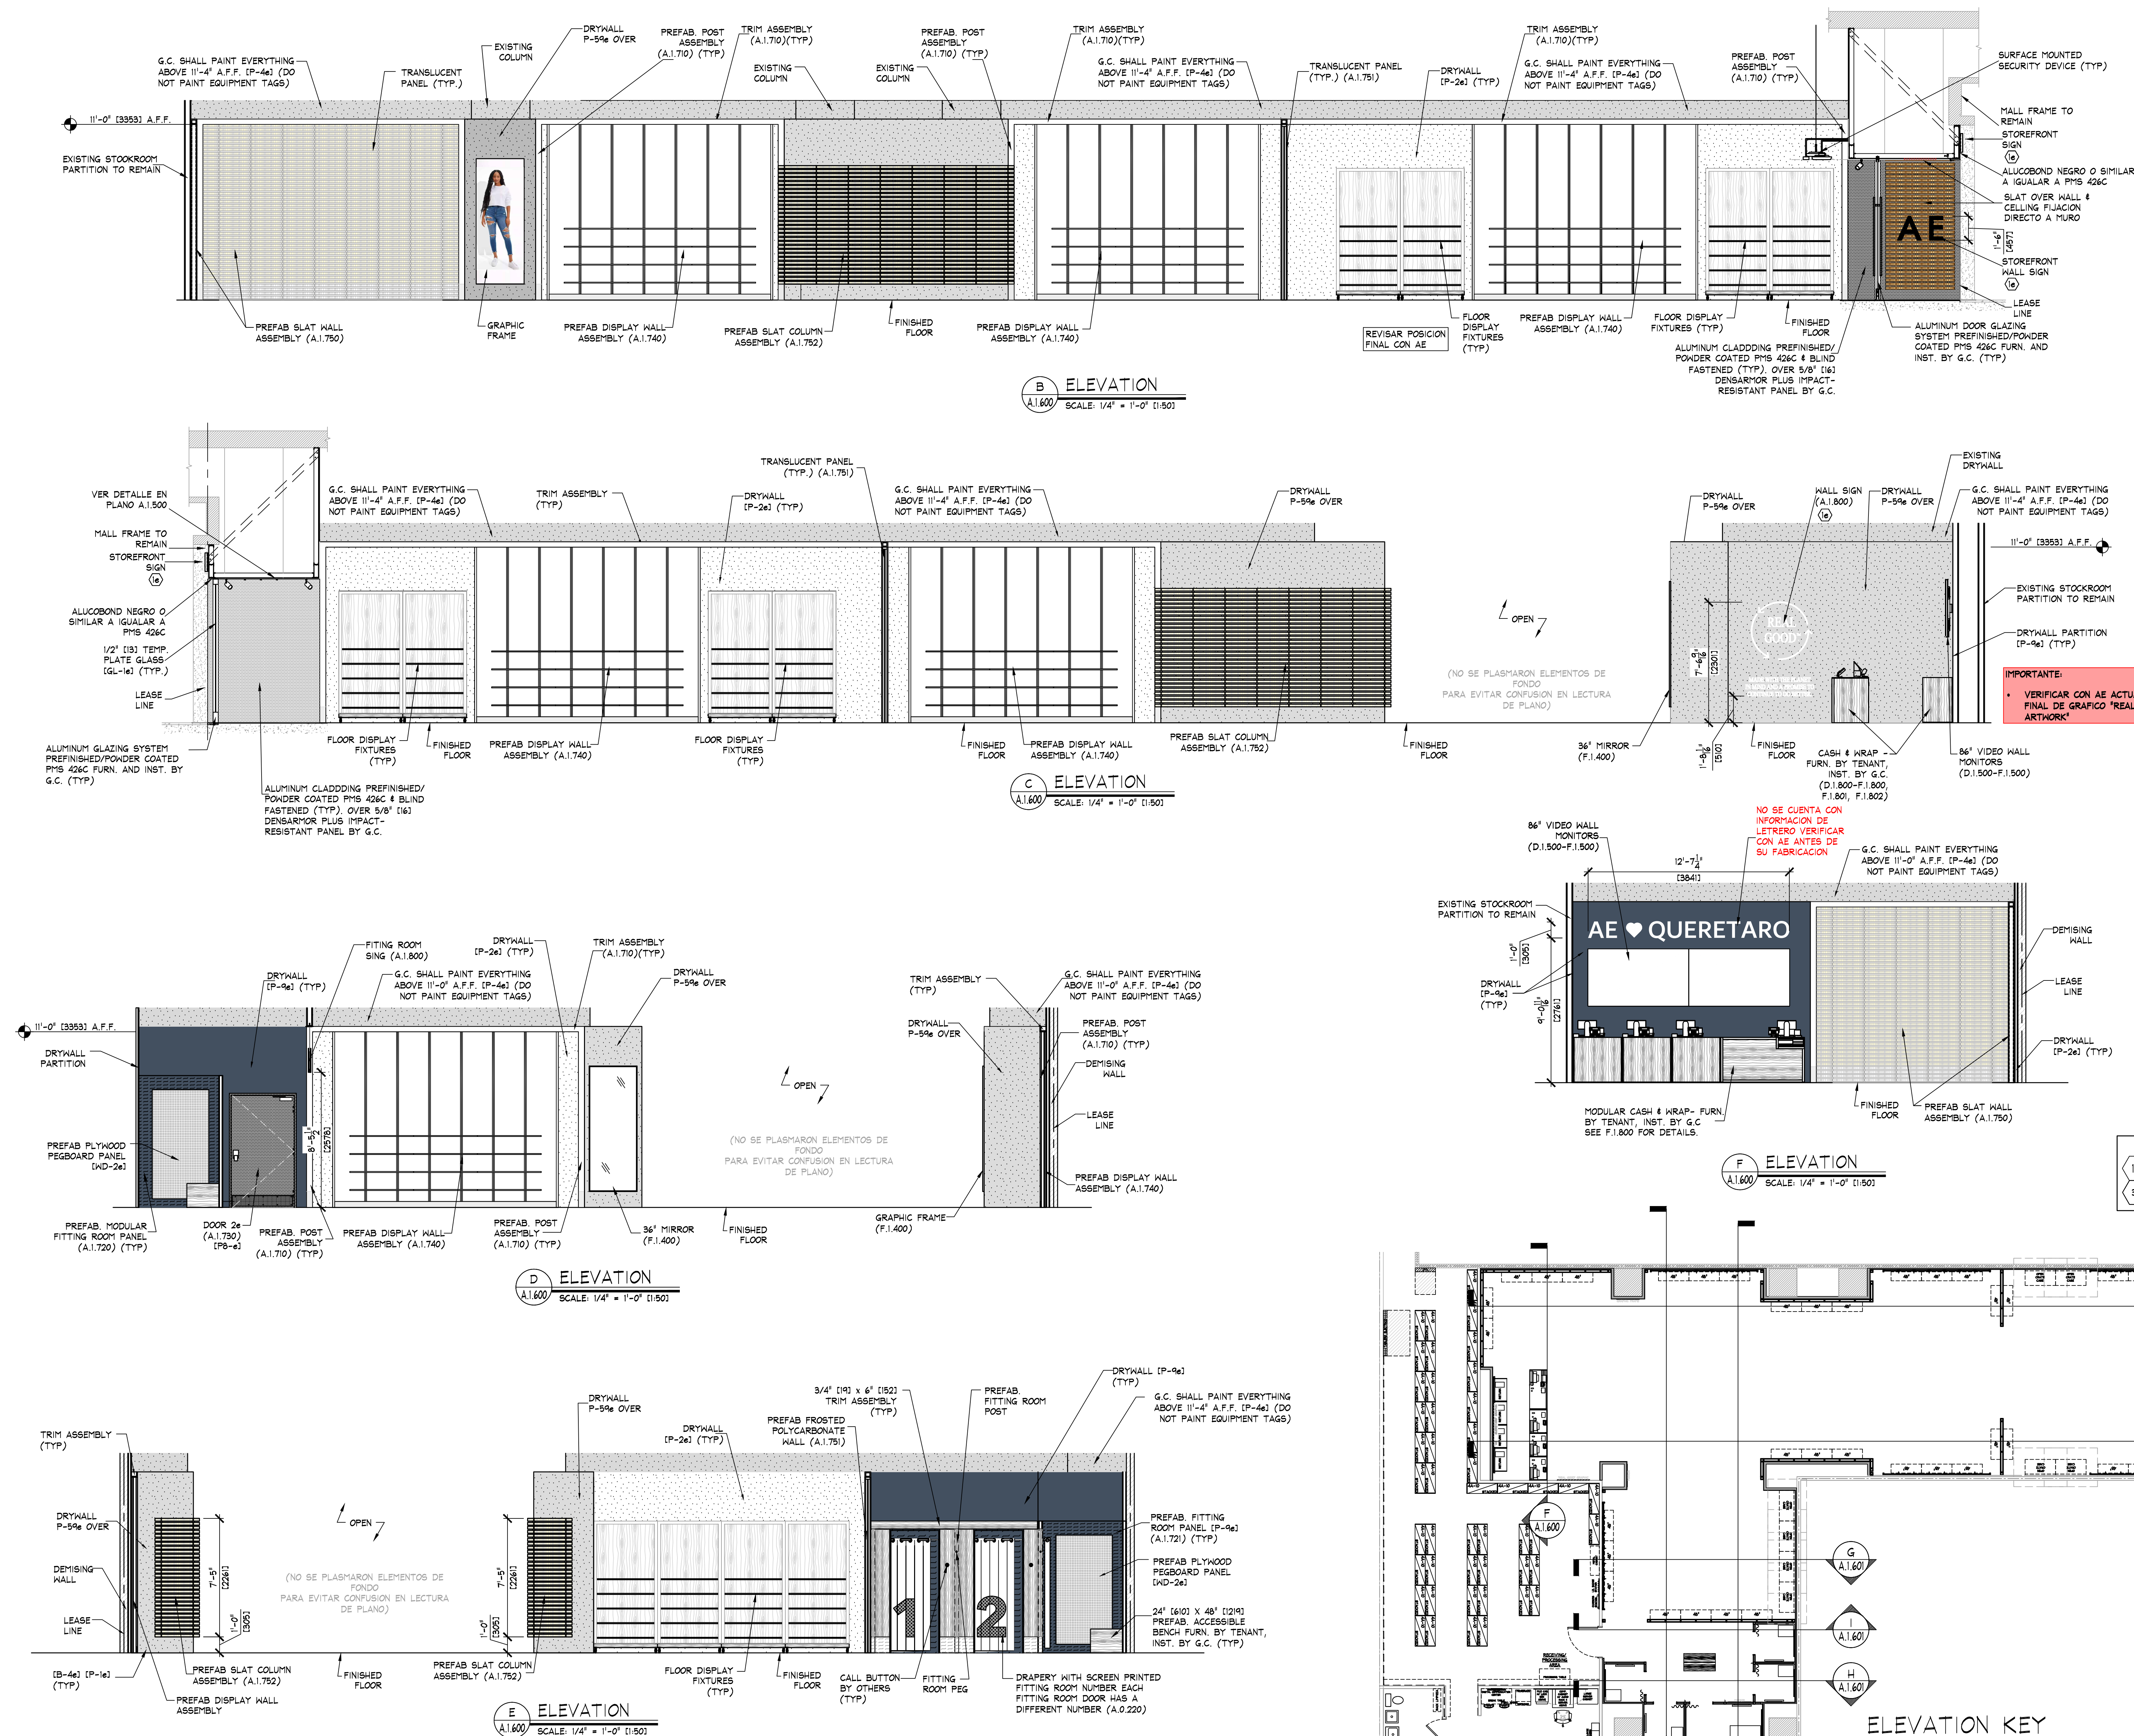

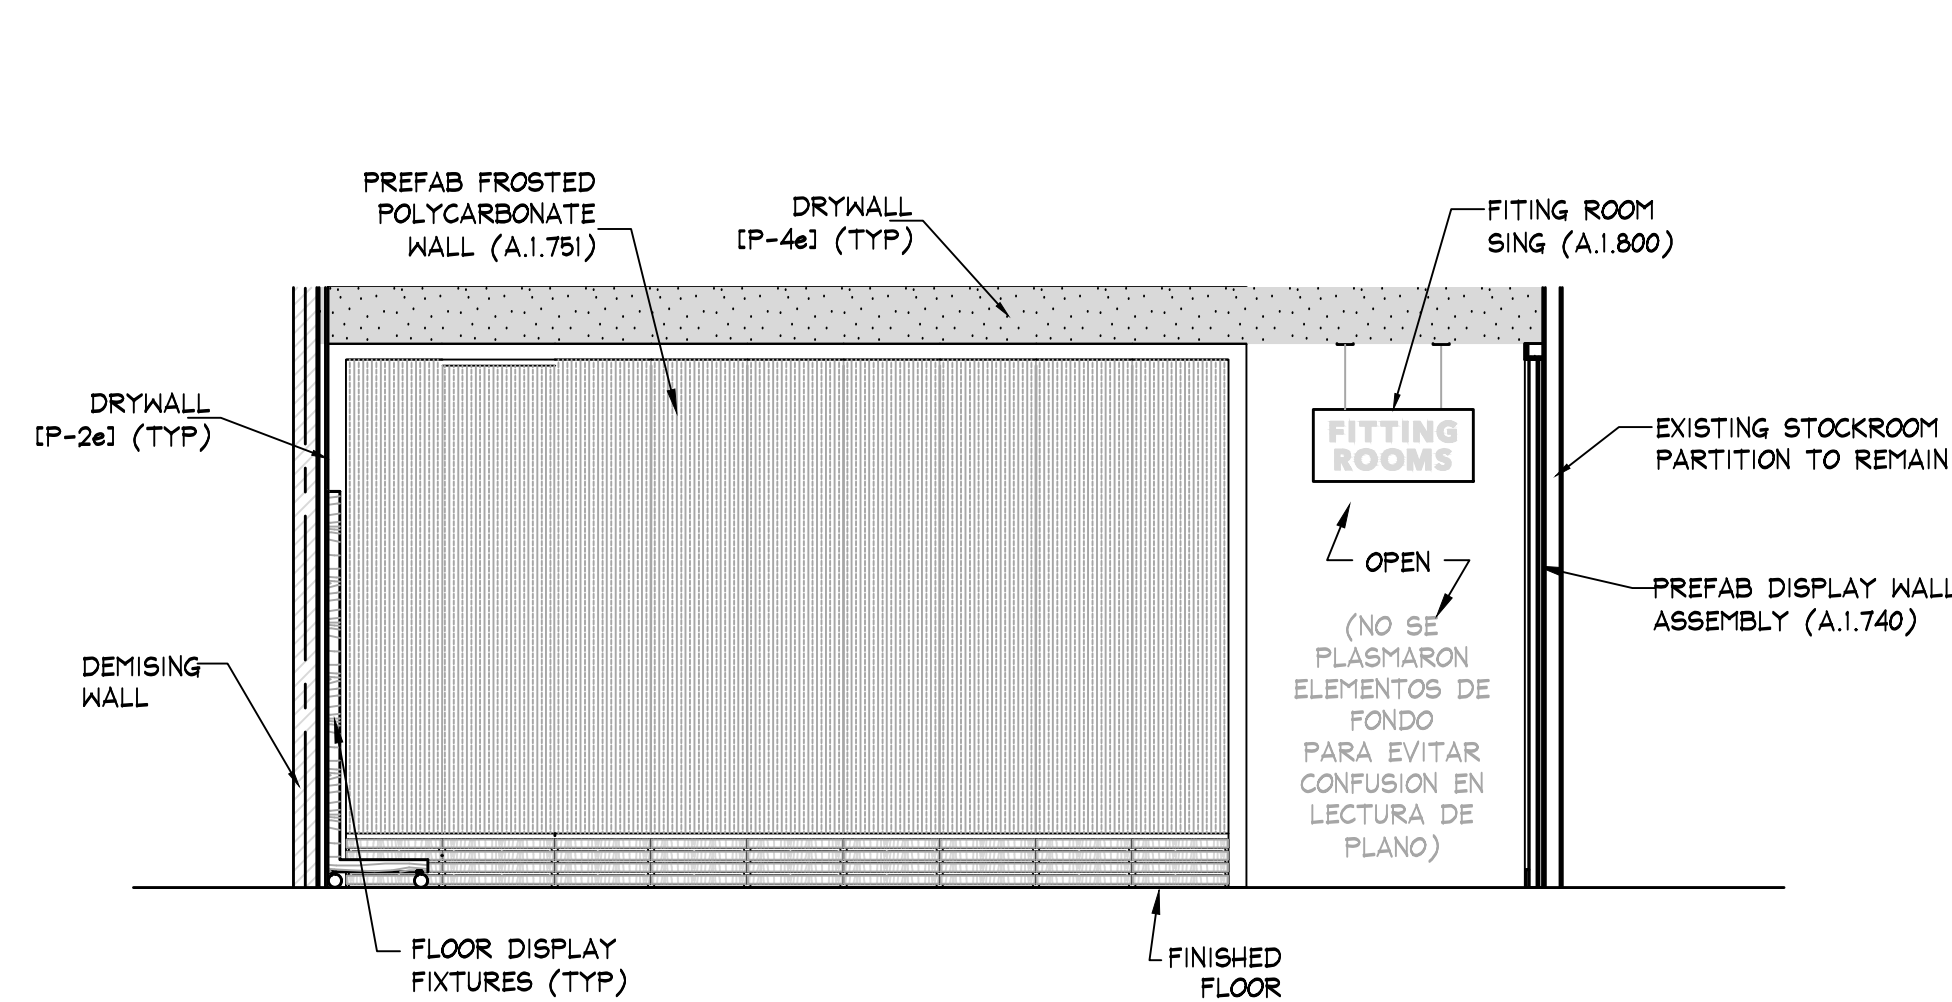

G ELEVATION
A.1.601 SCALE: 1/4" = 1'-0" (1:50)

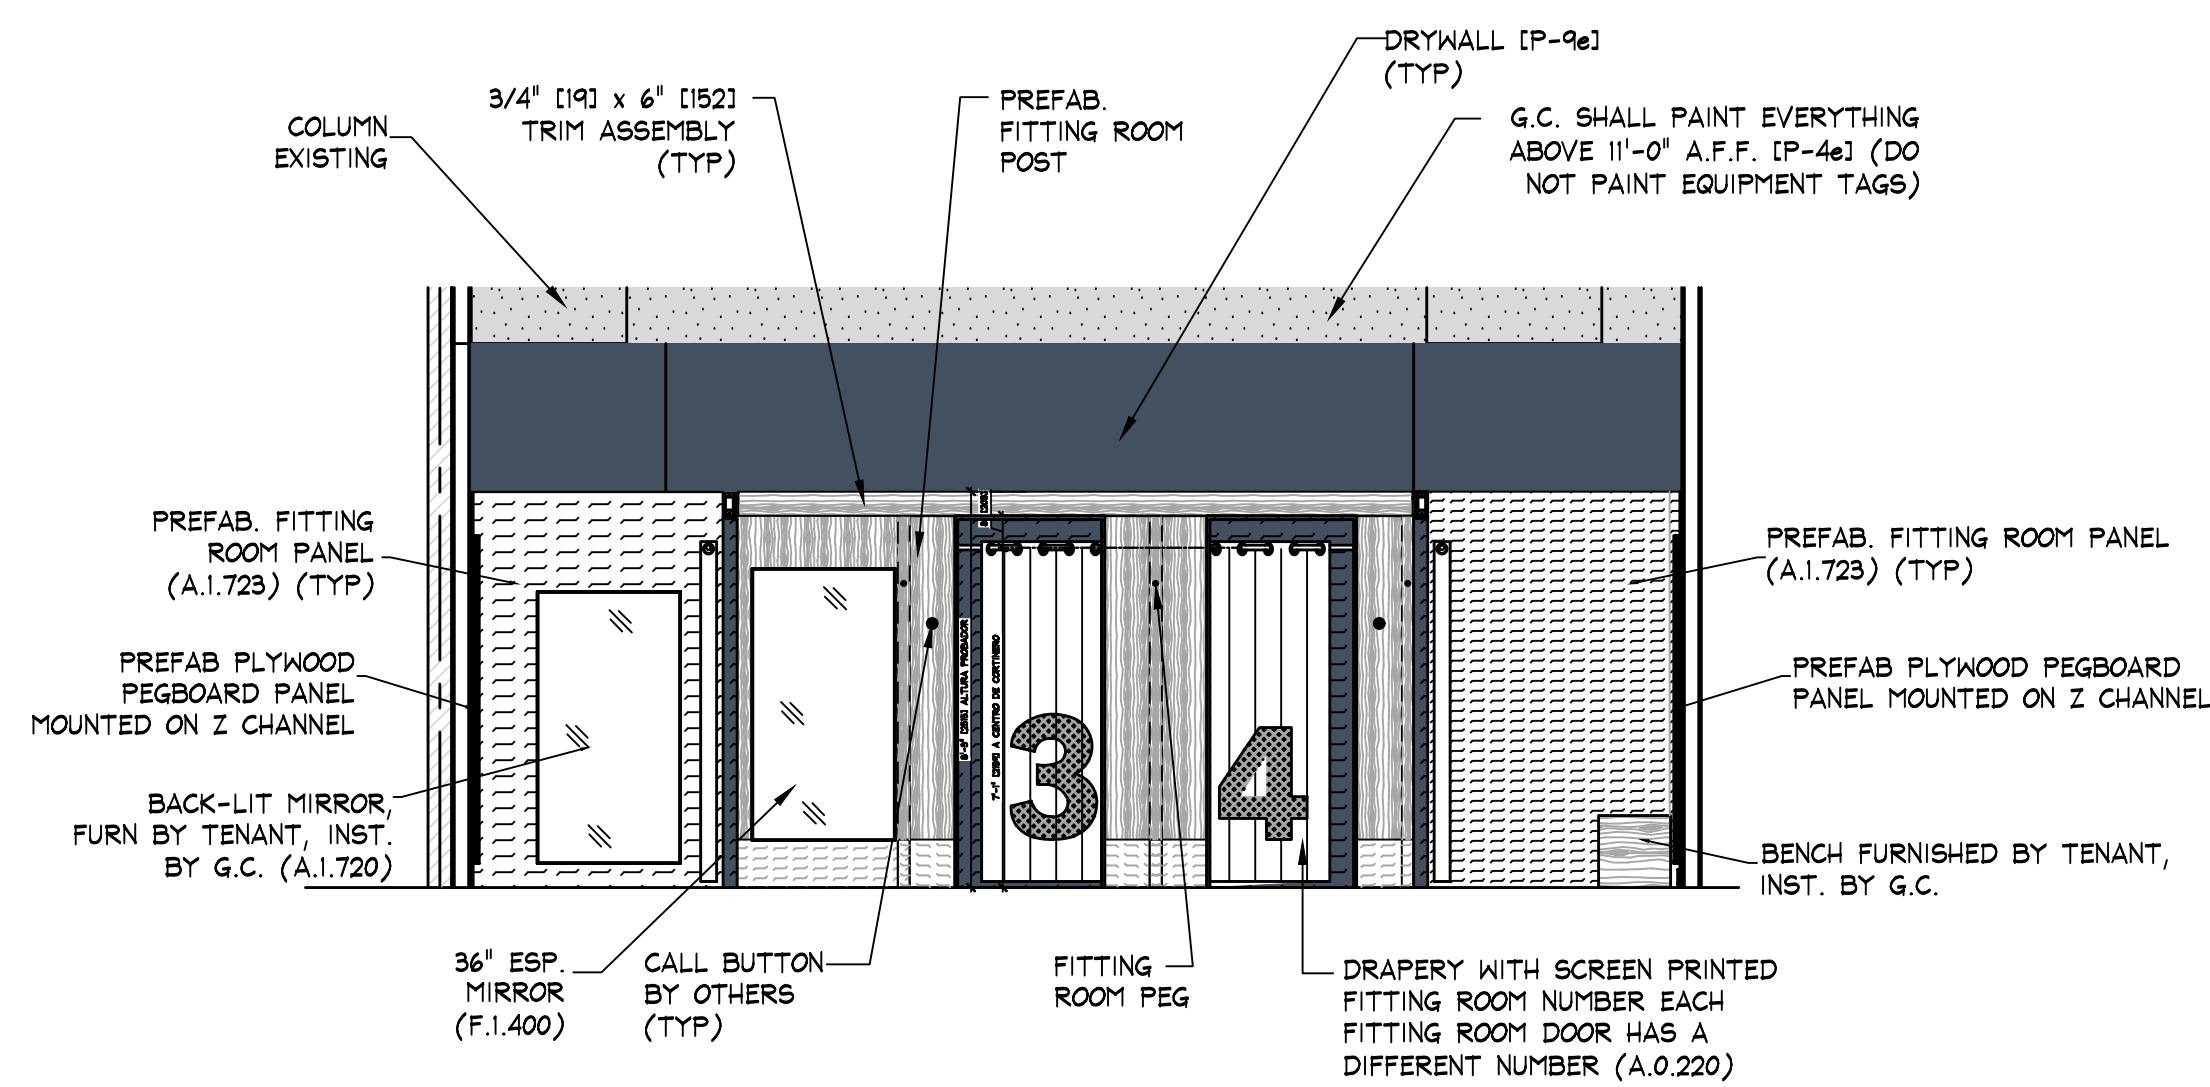


H ELEVATION
A.1.601 SCALE: 1/4" = 1'-0" (1:50)

KEY NOTES:
1e SIGN - FURNISHED BY SIGN CONSULTANT, INST. BY G.C. - SEE SHEETS 'A.1.800' OR A.2.800 FOR MORE INFORMATION


NOTE:
PAINTING CONTRACTOR SHALL CAULK ALL INSIDE WOOD CORNERS AND JOINTS BETWEEN TRIM & WALL PRIOR TO PAINTING

NOTE:
DETAILS, NOTES, AND/OR SPECIFICATIONS ON THIS SHEET NOT LISTED ALPHABETICALLY OR NUMERICALLY HAVE BEEN PURPOSELY OMITTED AND DO NOT PERTAIN TO THIS PROJECT.

KEY NOTES:
SIGN - FURNISHED BY SIGN CONSULTANT, INST. BY G.C. - SEE SHEETS 'A.1.800'

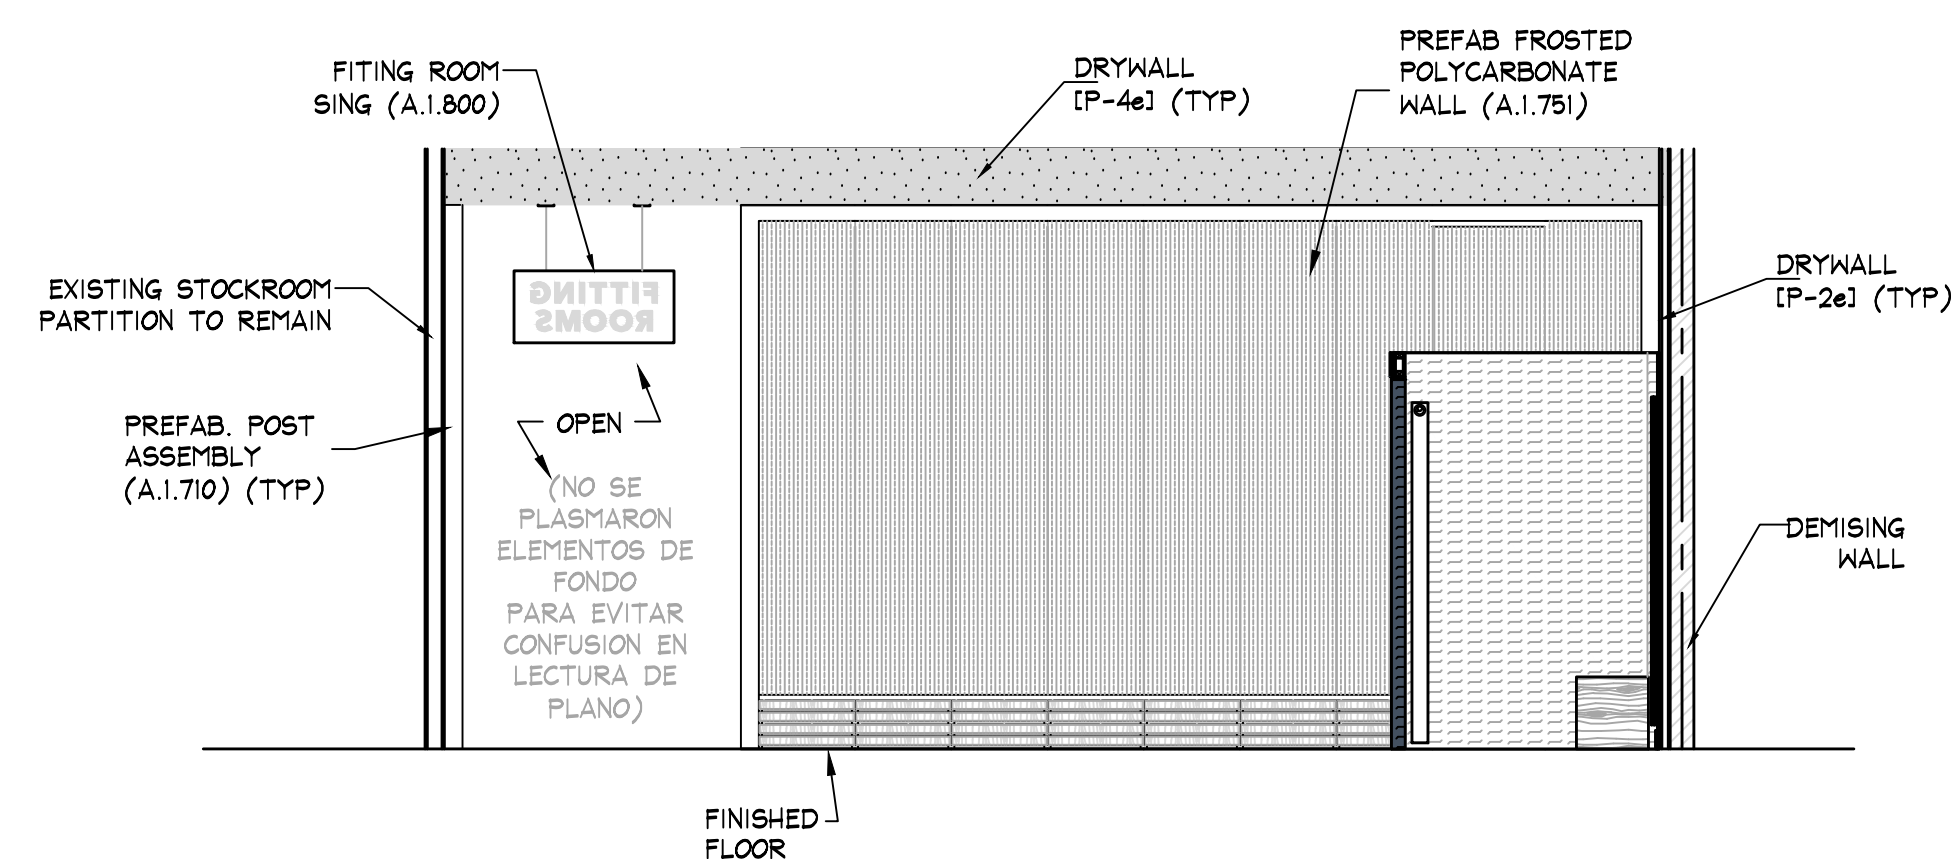

I ELEVATION
A.1.601 SCALE: 1/4" = 1'-0" (1:50)

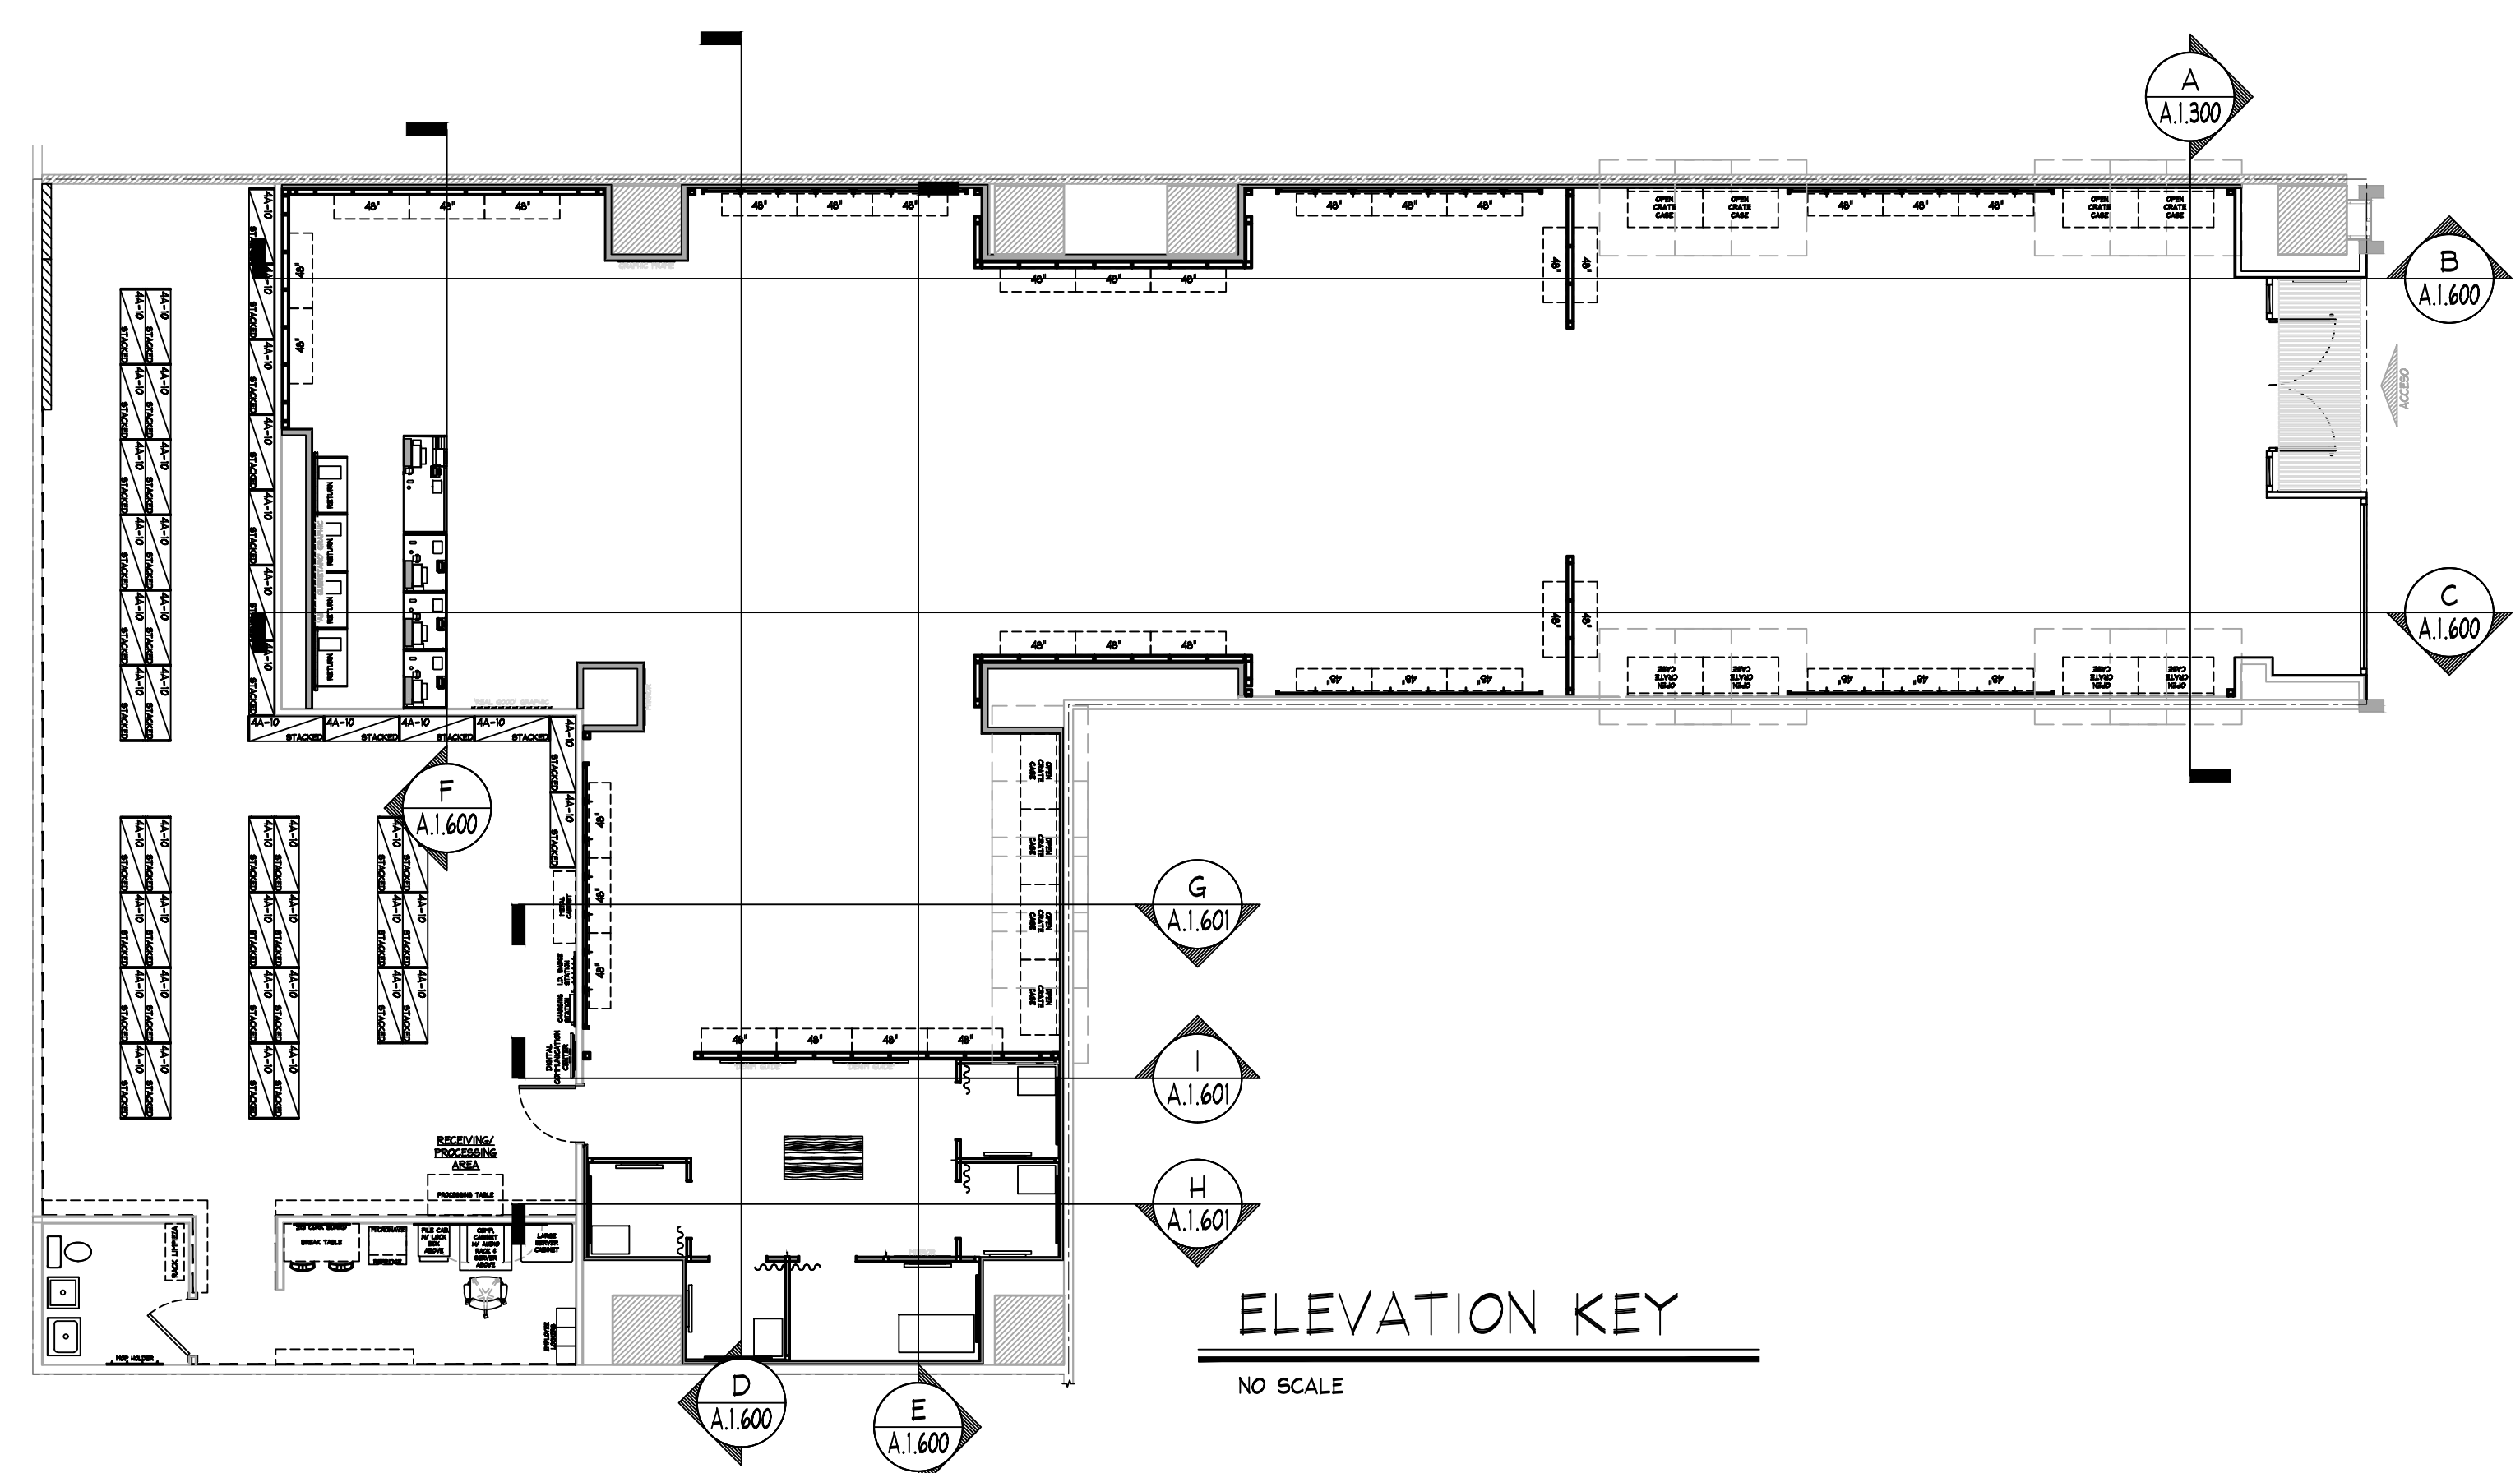

ELEVATION KEY

NO SCALE

AMERICAN EAGLE

AMERICAN EAGLE OUTFITTERS, INC.
77 Hot Metal Street
Pittsburgh, PA 15203
(412)-432-3300

A 10/17/20 GENERAL REVISION
B 10/17/20 GENERAL REVISION
C 11/13/20 GENERAL REVISION

OFFLINE INTERIOR ELEVATIONS
AMERICAN EAGLE OUTFITTERS
C. C. Antea Queretaro
Queretaro, Queretaro

Store No.

9206

Drawn by:

Drawing No.

A.1.601